

Re-Monumentation 1, Page 223

1998 REMONUMENTATION
LAND CORNER RECORDATION CERTIFICATE
Filing Requirement of Act 74, Mich. P.A. 1970

For Corners in MEADE Township

Huron
(County)

Located in:

Corner Code #

SURVEY &
REMONUMENTATION

STATE OF MICHIGAN
HURON COUNTY
RECORDED

1. Public Land Survey

T 17N R 12E E-13

JAN 28 1999

15 DEC 98 3:33 P.M.

2. Property Controlling
in Section

S T R
S T R
S T R

SECTION

FRANCES L. HOLDWICK
REGISTER OF DEEDS

3. Miscellaneous
Property in Sec.

S T R
S T R
S T R

Register of Deeds Stamp & File Number

4. Lot No. _____, Recorded Plat _____
5. Private Claims _____

I, Russell L. Brown, in a field survey on July 31, 1998 do hereby state that under requirements of P.A. 74, Michigan P.A. of 1970, the corner points mentioned in lines 1 and 2 above were in conformance with regulations and rules therefore as required in the current manual of survey instructions of the United States Department of the Interior, Bureau of Land Management or by a decree of a Court of Law and/or that the corner points mentioned in lines 3, 4, and 5 above were in conformance with the rules of the Michigan Board of Land Surveyors or by a Decree of a Court of Law; established, re-established, monumented, recovered, found as expressed below:

A	B	C	D	E	F	G	H	J	K	L	M
2	6		5		4		3		2		1
3											
4	7		8		9		10		11		12
5											
6	18		17		16		15		14		13
7											
8	19		20		21		22		23		24
9											
10	30		29		28		27		26		25
11											
12	31		32		33		34		35		36
13											

NOTE: Not more than 2 corners, all in the same town and range, may be recorded on this certificate.

A. Description of original monument and accessories and/or subsequent restoration:

G.L.O. H. Parke D.S. Set Post Corner Sections 32 and 33, Cedar 14 N75 1/2E 39; Cedar 8 N50 1/2W 22;

County Surveyors Records: NONE

County Road Commission Records: Iron Pin: Spike in Power Pole, N45°W 54.40'; Spike in Power Pole S50°W 45.95'; Face Flag Pole, N45°E 64.20';

Recorded Surveys: Over

Unrecorded Surveys: NONE

B. Description of corner evidence found and/or method applied in restoring or reestablishing corner:

No evidence of original corner or accessories found.

Found 1" Pipe

Accepted found 1" Pipe as best evidence of original corner position.

Recovered two witnesses that indicates 1" Pipe to be in same location as road commission records.

C. Description of monument for corner and accessories established to perpetuate locating the position of the corner:

E-13, Corner Sections 32 and 33, T17N-R12E

Found 1" Pipe

WITNESSES:

S50°W 45.89' found Spike in Southeast Face Power Pole

N40°W 54.29' found Spike in Southwest Face Power Pole

N30°E 68.63' found Spike in West Face Power Pole

S45°E 33.10' Set "V" Notch in East End 18" C.S.P.


East 2638.94' to F-13, South 1/4 Corner Section 33, T17N-R12E

West 2643.39' to D-13, South 1/4 Corner Section 32, T17N-R12E

Signed by Russell L. Brown

Surveyor's Michigan License No. 24588

Date Dec 7, 1998

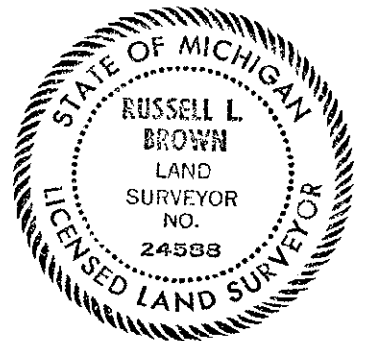

Peer group approved at meeting held December 8, 1998. RLB

Liber 1, Page 223 A

Recorded Surveys:

November 8, 1972, Liber 1, Page 372, by Stewart G. Case P.S. 15399

3/4" Steel Pin in place and raised with 1" Pipe

WITNESSES

Spike on Southeast Side Telephone Pole, S15°W 45.90'

Spike on Southwest Side Telephone Pole, N45°W 54.35'

2" Steel Flag Pole, N45°E 64.35'

July 12, 1979 Liber 4 Page 124, by Stewart G. Case P.S. 15399

3/4" Steel Pin in place and raised with 1" pipe

WITNESSES

Spike in Southeast Side Telephone Pole, S15°W 45.90'

Spike in Southwest Side Telephone Pole, N45°W 54.35'

2" Steel Flag Pole, N45°E 64.35'

\$ 9.00 SURVEY

\$ 2.00 MSSR

SURVEY &
REMONUMENTATION

JAN 28 1999

SECTION