

Re-Mon Ledger 1, Page 224

1998 REMONUMENTATION
LAND CORNER RECORDATION CERTIFICATE
Filing Requirement of Act 74, Mich. P.A. 1970

For Corners in MEADE Township

Huron
(County)

Located in: Corner Code #

- 1. Public Land Survey T 17N R 12E F-13
- T _____ R _____
- T _____ R _____
- T _____ R _____
- 2. Property Controlling S _____ T _____ R _____
in Section S _____ T _____ R _____
- 3. Miscellaneous S _____ T _____ R _____
Property in Sec. S _____ T _____ R _____

SURVEY &
REMONUMENTATION

JAN 28 1999

SECTION

STATE OF MICHIGAN
HURON COUNTY
RECORDED

15 DEC 98 3:33 P.M.

FRANCES L. HOLDWICK
REGISTER OF DEEDS

Register of Deeds Stamp & File Number

- 4. Lot No. _____, Recorded Plat _____
- 5. Private Claims _____

I, Russell L. Brown, in a field survey on July 24, 1998 do hereby state that under requirements of P.A. 74, Michigan P.A. of 1970, the corner points mentioned in lines 1 and 2 above were in conformance with regulations and rules therefore as required in the current manual of survey instructions of the United States Department of the Interior, Bureau of Land Management or by a decree of a Court of Law and/or that the corner points mentioned in lines 3, 4, and 5 above were in conformance with the rules of the Michigan Board of Land Surveyors or by a Decree of a Court of Law; established, re-established, monumented, recovered, found as expressed below:

1	A	B	C	D	E	F	G	H	I	J	K	L	M
2	6	5	4	3	2	1							
3													
4	7	8	9	10	11	12							
5													
6	18	17	16	15	14	13							
7													
8	19	20	21	22	23	24							
9													
10	30	29	28	27	26	25							
11													
12	31	32	33	34	35	36							
13													

NOTE: Not more than 2 corners, all in the same town and range, may be recorded on this certificate.

A. Description of original monument and accessories and/or subsequent restoration:

1834 G.L.O. H. Parke D.S. Set quarter Section post, Hemlock 24 N50W 31,; Hemlock 9 N71E 15;
County Surveyors Records: NONE
County Road Commission Records: Iron Pin in line with Fence, North, Spike Telephone Pole, S02°E 56.50'; Spike in Power Pole, N35°E 45.80'
Recorded Surveys: NONE
Unrecorded Surveys: NONE

B. Description of corner evidence found and/or method applied in restoring or reestablishing corner:

No evidence of original corner or accessories found.


Found 3/4" Re-Rod

Accepted found 3/4" Re-Rod as best evidence of original corner position.

C. Description of monument for corner and accessories established to perpetuate locating the position of the corner:

F-13, South 1/4 Corner of Section 33, T17N-R12E
Found 3/4" Re-Rod
WITNESSES:
North 34.75' set Spike in East Face Stump
N45°E 45.70' set Spike in Southeast Face Power Pole
S45°E 35.44' set 1/2" Steel Stake
S45°W 28.60' set 1/2" Steel Stake

East 2633.42' to G-13, Corner Sections 33 and 34, T17N-R12E
West 2638.94' to E-13, Corner Sections 32 and 33, T17N-R12E

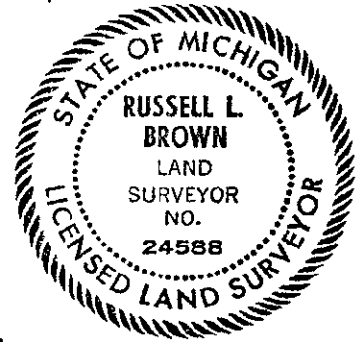

Signed by Russell L. Brown
Surveyor's Michigan License No. 24588

Date DEC 7, 1998

Peer group approved at meeting held December 8, 1998, R&B