

Re-Now Liber 1, Page 225

1998 REMONUMENTATION  
LAND CORNER RECORDATION CERTIFICATE  
Filing Requirement of Act 74, Mich. P.A. 1970

For Corners in MEADE Township

Huron  
(County)

Located in:

Corner Code #

SURVEY &  
REMONUMENTATION

STATE OF MICHIGAN  
HURON COUNTY  
RECORDED

- 1. Public Land Survey T 17N R 12E G-13  
T ----- R -----  
T ----- R -----  
T ----- R -----
- 2. Property Controlling S \_\_\_\_\_ T ----- R -----  
in Section S \_\_\_\_\_ T ----- R -----
- 3. Miscellaneous S \_\_\_\_\_ T ----- R -----  
Property in Sec. S \_\_\_\_\_ T ----- R -----

JAN 23 1999

15 DEC 98 3:33 P.M.

FRANCES L. HOLMICK  
REGISTER OF DEEDS

SECTION

Register of Deeds Stamp & File Number

- 4. Lot No. \_\_\_\_\_, Recorded Plat \_\_\_\_\_
- 5. Private Claims \_\_\_\_\_

1	A	B	C	D	E	F	G	H	I	J	K	L	M
2		6		5		4		3		2		1	
3													
4		7		8		9		10		11		12	
5													
6		18		17		16		15		14		13	
7													
8		19		20		21		22		23		24	
9													
10		30		29		28		27		26		25	
11													
12		31		32		33		34		35		36	
13													

I, Russell L. Brown, in a field survey on July 24, 1998 do hereby state that under requirements of P.A. 74, Michigan P.A. of 1970, the corner points mentioned in lines 1 and 2 above were in conformance with regulations and rules therefore as required in the current manual of survey instructions of the United States Department of the Interior, Bureau of Land Management or by a decree of a Court of Law and/or that the corner points mentioned in lines 3, 4, and 5 above were in conformance with the rules of the Michigan Board of Land Surveyors or by a Decree of a Court of Law; established, re-established, monumented, recovered, found as expressed below:

NOTE: Not more than 2 corners, all in the same town and range, may be recorded on this certificate.

A. Description of original monument and accessories and/or subsequent restoration:  
1834, G.L.O. H. Parke D.S. Set Post Corner Sections 33 and 34, Hemlock 26 N40E 33; Hemlock 8 N59W 21;  
County Surveyors Records: NONE  
County Road Commission Records: Axle; Spike 12" Cal. Maple, N50°W 43.90'; Spike 4" Cal. Maple, S40°E 53.80';  
Spike in Telephone Pole, N60°E 46.65'; Spike in Telephone Pole S45°E 43.80';  
Recorded Surveys; March 15, 1976, Liber 2, Page 561, by Stewart G. Case P.S. 15399, 3/4" Steel Pipe in Place  
WITNESSES: Spike in S.E. Side Telephone Pole, N45°E 46.75'; Spike in E. Side Telephone Pole, S45°E 43.70';  
Spike in N. Side Power Pole, S55°E 61.67';  
Unrecorded Surveys: NONE

B. Description of corner evidence found and/or method applied in restoring or reestablishing corner:  
No evidence of original corner or accessories found.

Found 1" Steel Bar

Accepted found 1" Steel Bar as best evidence of original corner position.

C. Description of monument for corner and accessories established to perpetuate locating the position of the corner:

G-13, Southeast Corner Section 33 and Southwest Corner Section 34, T17N-R12E


Found 1" Steel Bar

WITNESSES:

- N45°E 45.60' found Spike in Northwest Face of Fence Post
- S45°E 45.93' Southwest Corner Concrete Anchor Post
- N20°W 102.61' Northeast Corner Pump House
- S45°W 39.37' Set 1/2" Steel Stake

East 2637.61' to H-13, South 1/4 Corner Section 34, T17N-R12E

West 2633.42' to F-13, South 1/4 Corner Section 33, T17N-R12E

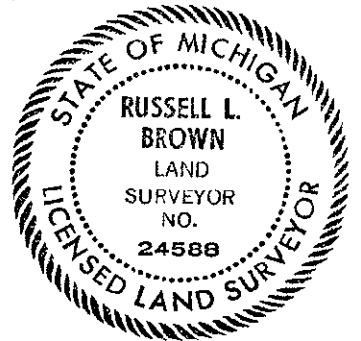

Signed by Russell L. Brown  
Surveyor's Michigan License No. 24588

Date DEC. 7, 1998

Peer group approved at meeting held December 8, 1998. R&B