

Re-Monumentation, Page 228

1998 REMONUMENTATION  
LAND CORNER RECORDATION CERTIFICATE  
Filing Requirement of Act 74, Mich. P.A. 1970

For Corners in MEADE Township

<u>Huron</u> (County)	Located in:	Corner Code #
1. Public Land Survey	T <u>17N</u> R <u>12E</u>	J-13
	T ----- R -----	_____
	T ----- R -----	_____
	T ----- R -----	_____
2. Property Controlling in Section	S ----- T ----- R -----	_____
	S ----- T ----- R -----	_____
3. Miscellaneous	S ----- T ----- R -----	_____
Property in Sec.	S ----- T ----- R -----	_____

SURVEY &  
REMONUMENTATION  
JAN 28 1999  
SECTION

STATE OF MICHIGAN  
HURON COUNTY  
RECORDED

15 DEC 98 3:34 P.M.

FRANCES L. HOLDWICK  
REGISTER OF DEEDS

Register of Deeds Stamp & File Number

4. Lot No. \_\_\_\_\_, Recorded Plat \_\_\_\_\_  
5. Private Claims \_\_\_\_\_

A	B	C	D	E	F	G	H	I	J	K	L	M
2	6	5	4	3	2	1						
3												
4	7	8	9	10	11	12						
5												
6	18	17	16	15	14	13						
7												
8	19	20	21	22	23	24						
9												
10	30	29	28	27	26	25						
11												
12	31	32	33	34	35	36						
13												

I, Russell L. Brown, in a field survey on July 24, 1998 do hereby state that under requirements of P.A. 74, Michigan P.A. of 1970, the corner points mentioned in lines 1 and 2 above were in conformance with regulations and rules therefore as required in the current manual of survey instructions of the United States Department of the Interior, Bureau of Land Management or by a decree of a Court of Law and/or that the corner points mentioned in lines 3, 4, and 5 above were in conformance with the rules of the Michigan Board of Land Surveyors or by a Decree of a Court of Law; established, re-established, monumented, recovered, found as expressed below:

NOTE: Not more than 2 corners, all in the same town and range, may be recorded on this certificate.

A. Description of original monument and accessories and/or subsequent restoration:  
1834 G.L.O. H. Parke D.S. Set quarter Section Post, Hemlock 10 N62W 18, Hemlock 6 North 15.  
County Surveyors Records: NONE  
County Road Commission Records: NONE  
Recorded Surveys: NONE  
Unrecorded Surveys: NONE

B. Description of corner evidence found and/or method applied in restoring or reestablishing corner:  
No evidence of original corner or accessories found.

Found 3/4" Re-Rod

Accepted found 3/4" Re-Rod as best evidence of original corner position.

C. Description of monument for corner and accessories established to perpetuate locating the position of the corner:  
J-13, South 1/4 Corner Section 35, T17N-R12E

Found 3/4" Re-Rod


WITNESSES:

North 33.71' found Spike in Southeast Face of Fence Post  
S45°W 44.20' found Bolt for Rat Guard on 8" Tile Main  
N55°W 51.42' found "V" Notch in West End 12" C.S.P.  
S75° W121.63' Set P.K. Nail in Northwest Face of Power Pole

East 2613.36' to K-13, Southeast Corner Section 35, T17N-R12E  
West 2618.96' to I-13, Southwest Corner Section 35, T17N-R12E

Signed by Russell L. Brown  
Surveyor's Michigan License No. 24588

Date DEC. 7, 1998

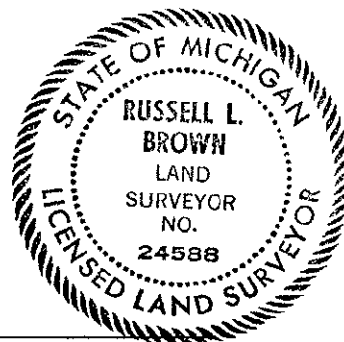

Peer group approved at meeting held December 8, 1998. RRB