

Re-Mon Ledger 1, Page 229

1998 REMONUMENTATION  
LAND CORNER RECORDATION CERTIFICATE  
Filing Requirement of Act 74, Mich. P.A. 1970

For Corners in MEADE Township

<u>Huron</u> (County)	Located in:	Corner Code #
1. Public Land Survey	T <u>17N</u> R <u>12E</u>	<u>K-13</u>
	T ----- R -----	_____
	T ----- R -----	_____
	T ----- R -----	_____
2. Property Controlling in Section	S _____ T ----- R -----	_____
	S _____ T ----- R -----	_____
3. Miscellaneous Property in Sec.	S _____ T ----- R -----	_____
	S _____ T ----- R -----	_____

SURVEY &  
REMONUMENTATION

JAN 28 1999

SECTION

STATE OF MICHIGAN  
HURON COUNTY  
RECORDED

15 DEC 98 3:34 P.M.

FRANCES L. HOLDWICK  
REGISTER OF DEEDS

Register of Deeds Stamp & File Number

HURON COUNTY

1	A	B	C	D	E	F	G	H	I	J	K	L	M
2	6		5		4		3		2		1		
3													
4	7		8		9		10		11		12		
5													
6	18		17		16		15		14		13		
7													
8	19		20		21		22		23		24		
9													
10	30		29		28		27		26		25		
11													
12	31		32		33		34		35		36		
13													

4. Lot No. \_\_\_\_\_, Recorded Plat \_\_\_\_\_  
5. Private Claims \_\_\_\_\_

I, Russell L. Brown, in a field survey on July 24, 1998 do hereby state that under requirements of P.A. 74, Michigan P.A. of 1970, the corner points mentioned in lines 1 and 2 above were in conformance with regulations and rules therefore as required in the current manual of survey instructions of the United States Department of the Interior, Bureau of Land Management or by a decree of a Court of Law and/or that the corner points mentioned in lines 3, 4, and 5 above were in conformance with the rules of the Michigan Board of Land Surveyors or by a Decree of a Court of Law; established, re-established, monumented, recovered, found as expressed below:

NOTE: Not more than 2 corners, all in the same town and range, may be recorded on this certificate.

A. Description of original monument and accessories and/or subsequent restoration:  
1834 G.L.O. H. Parke, D.S. Set Post Corner Sections 35 and 36, Beech 9 N43W 19, Cedar 8 N50E 25 1/2.  
County Surveyors Records: NONE  
County Road Commission Records: Iron Pin, Spike in Power Pole, N25E 96.50', Spike in Telephone Pole, N25W 93.60'  
Recorded Surveys: NONE  
Unrecorded Surveys: NONE

B. Description of corner evidence found and/or method applied in restoring or reestablishing corner:  
No evidence of original corner or accessories found.

Found 3/4" Re-Rod

Accepted found 3/4" Re-Rod as best evidence of original corner position.


C. Description of monument for corner and accessories established to perpetuate locating the position of the corner:  
K-13, Southwest Corner of Section 36, and Southeast Corner of Section 35, T17N-R12E,  
Found 3/4" Re-Rod

WITNESSES:  
S80°W 70.67' found Spike in Southeast Face of Power Pole  
S45°E 42.27' Set P.K. Nail in West Face of Power Pole  
N50°W 46.10' Cut "V" Notch in East End 12" C.M.P.  
N25°E 96.54' Set Spike in West Face of Power Pole

East 2652.54' to L-13, South 1/4 Corner Section 36, T17N-R12E  
West 2613.36' to J-13, South 1/4 Corner Section 35, T17N-R12E

Signed by Russell L. Brown  
Surveyor's Michigan License No. 24588

Date DEC 7, 1998

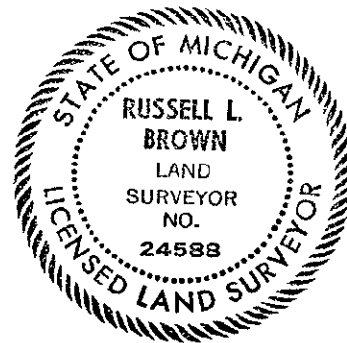

Peer group approved at meeting held December 8, 1998. R&B