

Re-Monumented, Page 230

1998 REMONUMENTATION
LAND CORNER RECORDATION CERTIFICATE
Filing Requirement of Act 74, Mich. P.A. 1970

For Corners in MEADE Township

STATE OF MICHIGAN
HURON COUNTY
RECORDED

Huron
(County)

Located in: Corner Code #

SURVEY &
REMONUMENTATION

15 DEC 98 3:34 P.M.

- 1. Public Land Survey T 17N R 12E L-13
T ----- R -----
T ----- R -----
T ----- R -----
- 2. Property Controlling S ----- T ----- R -----
in Section S ----- T ----- R -----
- 3. Miscellaneous S ----- T ----- R -----
Property in Sec. S ----- T ----- R -----

JAN 28 1999

FRANCES L. HOLDWICK
REGISTER OF DEEDS

SECTION

Register of Deeds Stamp & File Number

- 4. Lot No. _____, Recorded Plat _____
- 5. Private Claims _____

A	B	C	D	E	F	G	H	I	J	K	L	M
2	6		5		4		3		2		1	
3												
4	7		8		9		10		11		12	
5												
6	18		17		16		15		14		13	
7												
8	19		20		21		22		23		24	
9												
10	30		29		28		27		26		25	
11												
12	31		32		33		34		35		36	
13												

I, Russell L. Brown, in a field survey on July 24, 1998 do hereby state that under requirements of P.A. 74, Michigan P.A. of 1970, the corner points mentioned in lines 1 and 2 above were in conformance with regulations and rules therefore as required in the current manual of survey instructions of the United States Department of the Interior, Bureau of Land Management or by a decree of a Court of Law and/or that the corner points mentioned in lines 3, 4, and 5 above were in conformance with the rules of the Michigan Board of Land Surveyors or by a Decree of a Court of Law; established, re-established, monumented, recovered, found as expressed below:

NOTE: Not more than 2 corners, all in the same town and range, may be recorded on this certificate.

A. Description of original monument and accessories and/or subsequent restoration:
1834 G.L.O. H. Parke, D.S. Set quarter Section Post, Cedar 7, N37 1/2 W 12, Lynn 8, N64E, 25.
County Surveyors Records: NONE
County Road Commission Records: Iron Pin in line with Fence North Spike in Power Pole, S40°W 48.0'.
Recorded Surveys: Over
Unrecorded Surveys: NONE

B. Description of corner evidence found and/or method applied in restoring or reestablishing corner:
No evidence of original corner or accessories found.


Found 3/4" Re-Rod, Found two accessories that indicates the 3/4" Re-Rod found to be in same location as surveys stated in Section A above.

Accepted 3/4" Re-Rod found as best evidence of original corner position.

C. Description of monument for corner and accessories established to perpetuate locating the position of the corner:

L-13, South 1/4 Corner Section 36, T17N-R12E
Found 3/4" Re-Rod
WITNESSES:
North 32.52' found Spike in West Face of Fence Post
S40°W 48.02' found Spike in Northwest Face of Power Pole
N80°W 138.03' Set P.K. Nail in Northeast Face of Wood Post
S45°E 46.12' Cut "V" Notch in West End 12" C.M.P.

East 2646.31' to M-13, Southeast Corner Section 36, T17N-R12E
West 2652.54' to K-13, Southwest Corner Section 36, T17N-R12E

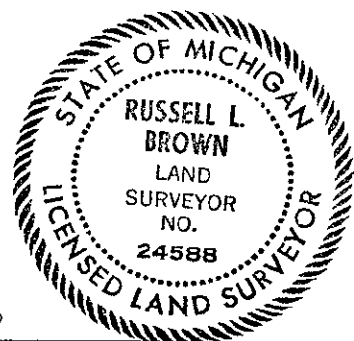

Signed by Russell L. Brown
Surveyor's Michigan License No. 24588

Date DEC. 7 1998

Peer group approved at meeting held December 8, 1998. RRB

Liber 1, Page 230A

Recorded Surveys

October 10, 1974, Liber 2, Page 238, by Stewart G. Case P.S. 15399,
3/4" Iron Pin in Place

WITNESSES:

Spike in Northwest Side of Power Pole, S55°W 47.95'

Spike in West Side of Corner Post, North 32.60'

Spike in Southeast Side of Fence Post, N65°E 67.25'

March 31, 1978, Liber 3, Page 463 by Stewart G. Case P.S. 15399

3/4" Iron Pin in Place

WITNESSES:

Spike in Northwest Side of Power Pole, S55°W 47.95'

Spike in West Side of Corner Post, North 32.60'

Spike in Southeast Side of Fence Post, N65°E 67.25'

March 14, 1977, Liber 3 Page 224, by Stewart G. Case P.S. 15399,

3/4" Iron Pine in Place

WITNESSES:

Spike in Northwest Side of Power Pole, S55°W 47.95'

Spike in West Side of Corner Post, North 32.60'

Spike in Southeast Side of Fence Post, N65°E 67.25'

\$ 9.00 SURVEY

\$ 2.00 HSSR

SURVEY &
REMONUMENTATION

JAN 28 1999

SECTION