

Common to:
 M13 - Hume Twp. - T18N-R12E
 A13 - Dwight Twp. - T18N-R13E
 A01 - Lincoln Twp. - T17N-R13E

Re - Mon. Leher 2, Page 19

1999 REMONUMENTATION

LAND CORNER RECORDATION CERTIFICATE
Filing Requirement of Act 74, Mich. P.A. 1970

For Corners in

<u>Huron</u> (County)	Located in:	Corner Code #
1. Public Land survey: <u>Hume</u>	T <u>18</u> N R 12 E	<u>M-1</u>
	T _____ R _____	<u>M-13</u>
	T _____ R _____	_____
	T _____ R _____	_____
2. Property Controlling in Section	S _____ T _____ R _____	_____
	S _____ T _____ R _____	_____
3. Miscellaneous Property in Sec.	S _____ T _____ R _____	_____
	S _____ T _____ R _____	_____
4. Lot No. _____, Recorded Plat _____		
5. Private Claims _____		

RECORDED

Dec 28 4 20 PM '99

Francis Holbrook
 REGISTER OF DEEDS
 HURON COUNTY, MICHIGAN

Register of Deeds Stamp & File Number

A	B	C	D	E	F	G	H	I	J	K	L	M
2	8	5	4	3	2	1						
3												
4	7	8	9	10	11	12						
5												
6	18	17	16	15	14	13						
7												
8	19	20	21	22	23	24						
9												
10	30	29	28	27	26	25						
11												
12	31	32	33	34	35	36						
13												

I, James T. Meek, in a field survey on October 30, 1999, do hereby certify that under requirements of P.A. 74, Michigan P.A. of 1970, the corner points mentioned in lines 1 and 2 above were in conformance with regulations and rules thereof as required in the current manual of survey instructions of the United States Department of the Interior, Bureau of Land Management or by a decree of a Court of Law and/or that the corner points mentioned in lines 3, 4 and 5 above were in conformance with the rules of the Michigan Board of Land Surveyors or by a Decree of a Court of Law; established, re-established, monumented, re-monumented, recovered, found as expressed below:

NOTE: Not more than 2 corners, all in the same town and range, may be recorded on this certificate.

A. Description of original monument and accessories and/or subsequent restoration:
 Original survey, South Bdy. T18NR12E, 1835, Harvey Parke D.S.

M-1 Corner of Townships 17 & 18 North, Ranges 12 & 13 East
 Post
 Pine 20", S85 1/2°W, 22 1/2 links
 Elm 10", N78°E, 2 links
 County Surveyor's Record: iron in mon box
 Recorded Surveys: L1, P339; L1, P377; L3, P717;
 L1, P46; L2, P250
 LCRC: none

RECORDED
 FEB 02 2000
 SECTION


B. Description of corner evidence found and/or method applied in restoring or reestablishing corner:

M-1 Corner of Townships 17 & 18 North, Ranges 12 & 13 East
 Found 1/2" iron w/cap in mon box. At intersection of Kinde Road & Michigan Highway M-53 (Van Dyke Road).
 Accepted as the best available evidence of the original corner position.

C. Description of monument for corner and accessories established to perpetuate locating the position of the corner:

M-1 Corner of Townships 17 & 18 North, Ranges 12 & 13 East
 1/2" iron w/cap in mon box
 From which:
 Tag in power pole bears N40°E, 64.0'
 School sign post bears S60°E, 99.4'
 Tag in power pole bears S45°W, 68.25'
 Road sign post bears N45°W, 51.5'

* Rerecording
 to correct
 erroneous
 town &
 range and
 corner.
 Date: 12/29/99

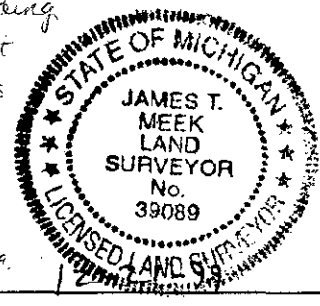

Signed by [Signature]
 Surveyor's Michigan License No. 39089

APPROVED AT PEER BOARD MEETING RLB 12-16-99