

Re-Mon Leber 2, Page 8,

1999 REMONUMENTATION

LAND CORNER RECORDATION CERTIFICATE
Filing Requirement of Act 74, Mich. P.A. 1970

For Corners in
Huron
(County)

Located in: _____ Corner Code # _____

1. Public Land survey: Meade T 17_N_ R 12_E M-1
 T _____ R _____
 T _____ R _____
 T _____ R _____

2. Property Controlling S _____ T _____ R _____
 in Section S _____ T _____ R _____

3. Miscellaneous S _____ T _____ R _____
 Property in Sec. S _____ T _____ R _____

4. Lot No. _____, Recorded Plat _____

5. Private Claims _____

STATE OF MICHIGAN
HURON COUNTY
RECORDED
29 NOV 2000 11:20 AM
FRANCES L. HOLDWICK
REGISTER OF DEEDS

Register of Deeds Stamp & File Number

	A	B	C	D	E	F	G	H	I	J	K	L	M
2	6		5		4		3		2		1		
3													
4	7		8		9		10		11		12		
5													
6	18		17		16		15		14		13		
7													
8	19		20		21		22		23		24		
9													
10	30		29		28		27		26		25		
11													
12	31		32		33		34		35		36		
13													

I, James T. Meek, in a field survey on October 30, 1999, do hereby certify that under requirements of P.A. 74, Michigan P.A. of 1970, the corner points mentioned in lines 1 and 2 above were in conformance with regulations and rules thereof as required in the current manual of survey instructions of the United States Department of the Interior, Bureau of Land Management or by a decree of a Court of Law and/or that the corner points mentioned in lines 3, 4 and 5 above were in conformance with the rules of the Michigan Board of Land Surveyors or by a Decree of a Court of Law; established, re-established, monumented, re-monumented, recovered, found as expressed below:

NOTE: Not more than 2 corners, all in the same town and range, may be recorded on this certificate.

A. Description of original monument and accessories and/or subsequent restoration:
Original survey, North Bdy. T17NR12E, 1835, Harvey Parke D.S.
M-1 Corner of Townships 17 & 18 North,
Ranges 12 & 13 East
Post
Pine 20", S85½°W, 22½ links
Elm 10", N78°E, 2 links
County Surveyor's Record: iron in mon box
Recorded Surveys: L1, P339; L1, P377; L3, P717;
L1, P46; L2, P250
LCRC: none

SURVEY &
REMONUMENTATION
JAN 19 2001
SECTION

B. Description of corner evidence found and/or method applied in restoring or reestablishing corner:

M-1 Corner of Townships 17 & 18 North,
Ranges 12 & 13 East

Found ½" iron w/cap in mon box. At intersection of Kinde Road & Michigan Highway M-53 (Van Dyke Road).

Accepted as the best available evidence of the original corner position.


C. Description of monument for corner and accessories established to perpetuate locating the position of the corner:

M-1 Corner of Townships 17 & 18 North,
Ranges 12 & 13 East

½" iron w/cap in mon box

From which:
Tag in power pole bears N40°E, 64.0'
School sign post bears S60°E, 99.4'
Tag in power pole bears S45°W, 68.25'
Road sign post bears N45°W, 51.5'

Signed by [Signature] Date 2000
Surveyor's Michigan License No. 39089

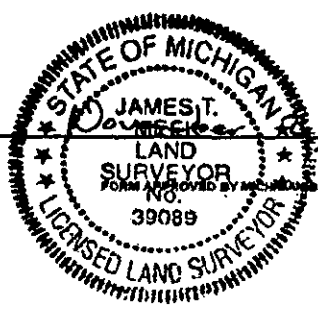

APPROVED AT PEER BOARD MEETING 11-02-00 RdB

STATE BOARD OF LAND SURVEYORS, JAN 28, 197
REVISED MAY 14, 197
REVISED JAN, 198
REVISED OCT., 198