

Common to:
 M01 - Meade Twp. - T17N-R12E
 M13 - Hume Twp. - T18N-R12E
 A13 - Dwight Twp. - T18N-R13E

Re Mon Liber 1, Page 264

1999 REMONUMENTATION

LAND CORNER RECORDATION CERTIFICATE
 Filing Requirement of Act 74, Mich. P.A. 1970

For corners in

Huron (County)	Located In:	Corner Code #
1. Public Land Survey	Lincoln T17NR13E	A-1
	T R	
	T R	
	T R	
2. Property Controlling in Section	S T R	
	S T R	
3. Miscellaneous Property in Sec.	S T R	
	S T R	

STATE OF MICHIGAN
 HURON COUNTY
 RECORDED

28 OCT 99 9:18 A.M.

FRANCES L. HOLWICK
 REGISTER OF DEEDS

Register of Deeds Stamp & File Number

4. Lot No. _____, Recorded Plat _____
 5. Private Claims _____

I, Charles S. Getz, in a field survey on April 12, 1999 do hereby state that under requirements of P.A. 74, Michigan P.A. of 1970, the corner points mentioned in lines 1 and 2 above were in conformance with regulations and rules therefore as required in the current manual of survey instructions of the United States Department of the Interior, Bureau of Land Management or by a decree of a Court of Law and/or that the corner points mentioned in lines 3, 4 and 5 above were in conformance with the rules of the Michigan Board of Land Surveyors or by a Decree of a Court of Law; established, re-established, monumented, recovered, found as expressed below:

	A	B	C	D	E	F	G	H	I	J	K	L	M
1													
2	6		5		4		3		2		1		
3													
4	7		8		9		10		11		12		
5													
6	18		17		16		15		14		13		
7													
8	19		20		21		22		23		24		
9													
10	30		29		28		27		26		25		
11													
12	31		32		33		34		35		36		
13													

NOTE: Not more than 2 corners, all in the same town and range, may be recorded on this certificate.

A. Description of original monument and accessories and/or subsequent restoration:

A-1 1834 G.L.O., H. Parke D.S. County Road Commission Records - Monument Box
 Post Recorded Surveys - Case, 7-13-71, Liber 1, Page 46, Mon. Box
 Pine 20", S85 1/2°W, 22 1/2 Links Kay, 11-15-74, Liber 2, Page 250, Mon Box
 Elm 10", N78°E, 2 Links Unrecorded Surveys - Brown, 5-20-92, Mon Box
 L.C.R.C. - NONE Case, 8-25-92, Certificate shows Corner
 Milletics, 6-17-93, Certificate shows Corner
 County Surveyor Records -
 May 10th, 1891 - Survey shows Corner


B. Description of corner evidence found and/or method applied in restoring or reestablishing corner:

A-1
 NW Cor, Section 6, T17N-R13E
 Found 1/2" Iron Bar with Cap in Monument Box
 Accepted as the best available evidence of original corner position
 (Intersection of M-53 (Van Dyke Road) & Kinde Road)

RECORDED
 FEB 08 2000
 SECTION

C. Description of monument for corner and accessories established to perpetuate locating the position of the corner:

A-1
 NW Cor, Section 6, T17N-R13E
 Found 1/2" Iron Bar with Cap in Monument Box
 N45°E 64.80' to Nail in Power Pole
 S45°W 68.70' to Nail in Anchor Pole
 N50°W 54.70' to Northeast Corner of Concrete Abutment
 S65°E 67.00' to Northwest Corner of Catch Basin
 East 2652.26' to S 1/4 Cor, Sec 31, T18N-R13E

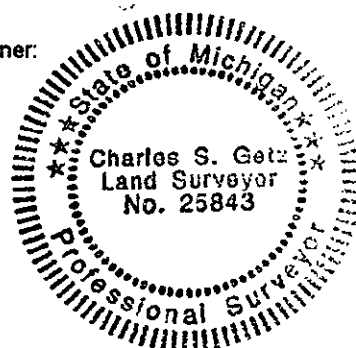

Signed by Charles S. Getz
 Surveyor's Michigan License No. 25843

Date August 14, 1999

PEER GROUP APPROVED AT MEETING
 HELD October 26, 1999 R.L.B.