

*Re Mon Liber 1, Page 210*

**1998 REMONUMENTATION  
LAND CORNER RECORDATION CERTIFICATE  
Filing Requirement of Act 74, Mich. P.A. 1970**

For Corners in LINCOLN Township

<u>Huron</u> (County)	Located in:	Corner Code #
1. Public Land Survey	T <u>17N</u> R <u>13E</u>	<u>A-13</u>
	T ----- R -----	_____
	T ----- R -----	_____
	T ----- R -----	_____
2. Property Controlling in Section	S _____ T ----- R -----	_____
	S _____ T ----- R -----	_____
3. Miscellaneous Property in Sec.	S _____ T ----- R -----	_____
	S _____ T ----- R -----	_____

**SURVEY &  
REMONUMENTATION**

JAN 28 1999

SECTION


STATE OF MICHIGAN  
HURON COUNTY  
RECORDED

15 DEC 98 3:30 P.M.

FRANCES L. HOLDWICK  
REGISTER OF DEEDS

Register of Deeds Stamp & File Number

4. Lot No. \_\_\_\_\_, Recorded Plat \_\_\_\_\_  
5. Private Claims \_\_\_\_\_

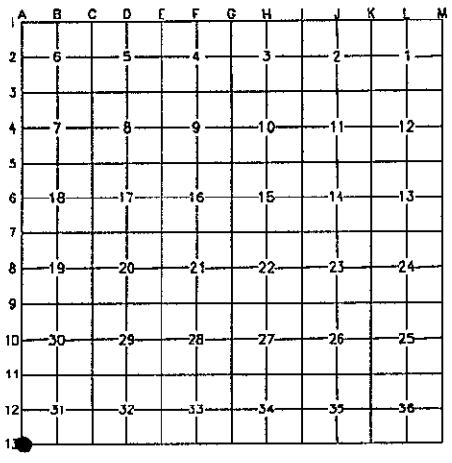

I, Russell L. Brown, in a field survey on July 17, 1998 do hereby state that under requirements of P.A. 74, Michigan P.A. of 1970, the corner points mentioned in lines 1 and 2 above were in conformance with regulations and rules therefore as required in the current manual of survey instructions of the United States Department of the Interior, Bureau of Land Management or by a decree of a Court of Law and/or that the corner points mentioned in lines 3, 4, and 5 above were in conformance with the rules of the Michigan Board of Land Surveyors or by a Decree of a Court of Law; established, re-established, monumented, recovered, found as expressed below:


NOTE: Not more than 2 corners, all in the same town and range, may be recorded on this certificate.

A. Description of original monument and accessories and/or subsequent restoration:  
1834 G.L.O. H. Parke D.S. Intersected Range line 1.45' South of Temporary Town Corner Post; B. Ash 13 S43E 2; Cedar 17 S82W 7;  
County Surveyors Records: NONE  
County Road Commission Records: Monument Box, 3" Cal. Maple N89°E 58.22'; 8" Cal. Maple S45°E 42.55'  
Recorded Surveys: Over  
Unrecorded Surveys: NONE

B. Description of corner evidence found and/or method applied in restoring or reestablishing corner:  
No evidence of original corner or accessories found.

Found 1" Steel Bar in Monument Box

Accepted found 1" Steel Bar in Monument Box as best evidence of original corner position.

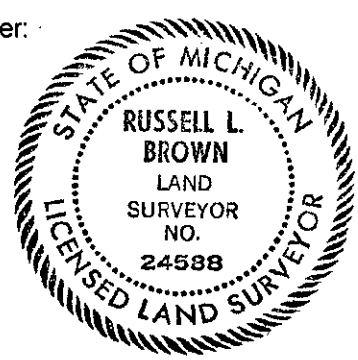

C. Description of monument for corner and accessories established to perpetuate locating the position of the corner:  
A-13, Southwest Corner of Section 31, T17N-R13E  
Found 1" Steel Bar in Monument Box  
WITNESSES:  
N45°W 57.02' Set 1/2" Steel Stake at Southeast Corner of Concrete Pad Ped. Base  
N45°E 50.40' Set 1/2" Steel Stake  
S65°W 75.50' Found Form Nail & MDOT Tag in Northwest side Power Pole  
S55°E 90.60' found Form Nail & MDOT Tag in Northeast side Power Pole  
East 6.90' to Centerline of State Trunkline M-53  
East 2484.06' to B-13, South 1/4 Corner Section 31, T17N-R13E  
West 2646.31' to L-13, South 1/4 Corner Section 36, T17N-R12E

NOTE:  
This corner common with  
M-13, T17N-R12E  
M-1, T16N-R12E  
A-1, T16N-R13E

Signed by Russell L. Brown Date DEC. 7, 1998  
Surveyor's Michigan License No. 24588

Peer group approved at meeting held December 8, 1998. *RXB*

*Liber 1, Page 210 A*

Recorded Surveys A-13 Lincoln

October 10, 1974, Liber 2, Page 238, by Stewart G. Case P.S. 15399  
Southeast Corner Section 36, T17N-R12E, Meade Township,  
Monument Box 5.0' West of centerline of Highway M-53,  
No Witnesses:

March 28, 1979 Liber 3, Page 715, by Stewart G. Case P.S. 15399  
Northeast Corner Fractional Section 1, T16N-R12E, 1" Steel Shaft in place in Monument Box  
approximately 5.0' West of centerline of Highway Right of Way.  
No Witnesses:

Liber 3, Page 760, by Stewart G. Case P.S. 15399  
Northeast Corner Fractional Section 1, T16N-R12E, 1" Steel Shaft in place in Monument Box  
approximately 5.0' West of centerline of Highway Right of Way.  
No Witnesses:

\$ 9.00 SURVEY  
\$ 2.00 MSSR

SURVEY &  
REMONUMENTATION

JAN 28 1999

SECTION