

LAND CORNER RECORDATION CERTIFICATE
 Filing Requirement of Act 74, Mich. P.A. 1970

For corners in

<u>Huron</u> <small>(County)</small>	Located In:	Corner Code #	
1. Public Land Survey	Lincoln	T17NR13E	L-13
		T___R___	_____
		T___R___	_____
		T___R___	_____
2. Property Controlling in Section	S___	T___R___	_____
	S___	T___R___	_____
3. Miscellaneous Property in Sec.	S___	T___R___	_____
	S___	T___R___	_____

STATE OF MICHIGAN
 HURON COUNTY
 RECORDED

25 NOV 98 10:02 A.M.

FRANCES L. HOLDWICK
 REGISTER OF DEEDS

Register of Deeds Stamp & File Number

4. Lot No. _____, Recorded Plat _____
 5. Private Claims _____

I, Charles S. Getz, in a field survey on Oct. 30, 1998 do hereby state that under requirements of P.A. 74, Michigan P.A. of 1970, the corner points mentioned in lines 1 and 2 above were in conformance with regulations and rules therefore as required in the current manual of survey instructions of the United States Department of the Interior, Bureau of Land Management or by a decree of a Court of Law and /or that the corner points mentioned in lines 3, 4 and 5 above were in conformance with the rules of the Michigan Board of Land Surveyors or by a Decree of a Court of Law; established, re-established, monumented, recovered, found as expressed below:

NOTE: Not more than 2 corners, all in the same town and range, may be recorded on this certificate.

	A	B	C	D	E	F	G	H	I	J	K	L	M
1													
2	6	5	4	3	2	1							
3													
4	7	8	9	10	11	12							
5													
6	18	17	16	15	14	13							
7													
8	19	20	21	22	23	24							
9													
10	30	29	28	27	26	25							
11													
12	31	32	33	34	35	36							
13													

A. Description of original monument and accessories and/or subsequent restoration:

L-13	County Surveyor Records - NONE
1834 G.L.O., H. Parke D.S.	County Road Commission Records - Iron Pin
Set quarter section post	Recorded Surveys - Survey Liber 2, Page 375, 3/4" steel pin in place.
Sugar 8", N69°E, 18 Links	Unrecorded Surveys - NONE
Hemlock 8", N59°W, 12 Links	

L.C.R.C. - NONE

B. Description of corner evidence found and/or method applied in restoring or reestablishing corner:

L-13
 S 1/4 Cor, Section 36, T17N-R13E
 Found 3/4" Iron Pin
 Accepted as the best available evidence of original corner position
 (On Rapson Road)


**SURVEY &
 REMONUMENTATION**

JAN 28 1999

SECTION

C. Description of monument for corner and accessories established to perpetuate locating the position of the corner:

L-13
 S 1/4 Cor, Section 36, T17N-R13E
 Found 3/4" Iron Pin
 West 10.35' to 3/4" Iron Pin
 N50°W 62.60' to C.M.P.
 S30°W 47.70' to N. End of C.M.P.
 N75°E 147.65' to Nail in Power Pole
 West 2641.12' to SW Cor, Sec 36, T17N-R13E
 East 2642.78' to SE Cor, Sec 36, T17N-R13E

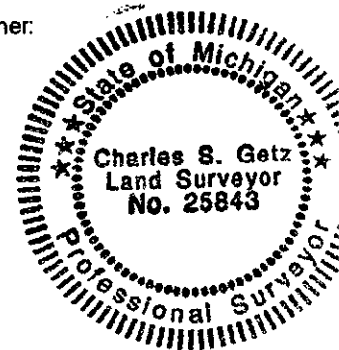

Signed by Charles S. Getz
 Surveyor's Michigan License No. 25843

Date October 31, 1998

PEER GROUP APPROVED AT
 MEETING 11-24-88 RLB