

Common to:
 A01 - Bloomfield Twp. - T17N-R14E
 A13 - Huron Twp. - T18N-R14E
 M13 - Dwight Twp. - T18N-R13E

Remon Liber 1, Page 265

1999 REMONUMENTATION

LAND CORNER RECORDATION CERTIFICATE
 Filing Requirement of Act 74, Mich. P.A. 1970

For corners in

Huron (County)	Located In:	Corner Code #
1. Public Land Survey	Lincoln T17N R13E	M-1
	T R	
	T R	
	T R	
2. Property Controlling in Section	S T R	
	S T R	
3. Miscellaneous Property in Sec.	S T R	
	S T R	

STATE OF MICHIGAN
 HURON COUNTY
 RECORDED

28 OCT 99 9:18 A.M.

FRANCES L. HOLDWICK
 REGISTER OF DEEDS

Register of Deeds Stamp & File Number

4. Lot No. _____, Recorded Plat _____
 5. Private Claims _____

I, Charles S. Getz, in a field survey on April 12, 1999 do hereby state that under requirements of P.A. 74, Michigan P.A. of 1970, the corner points mentioned in lines 1 and 2 above were in conformance with regulations and rules therefore as required in the current manual of survey instructions of the United States Department of the Interior, Bureau of Land Management or by a decree of a Court of Law and/or that the corner points mentioned in lines 3, 4 and 5 above were in conformance with the rules of the Michigan Board of Land Surveyors or by a Decree of a Court of Law; established, re-established, monumented, recovered, found as expressed below:

NOTE: Not more than 2 corners, all in the same town and range, may be recorded on this certificate.

	A	B	C	D	E	F	G	H	I	J	K	L	M
1													
2	6		5		4		3		2		1		
3													
4	7		8		9		10		11		12		
5													
6	18		17		16		15		14		13		
7													
8	19		20		21		22		23		24		
9													
10	30		29		28		27		26		25		
11													
12	31		32		33		34		35		36		
13													

A. Description of original monument and accessories and/or subsequent restoration:

M-1 1834 G.L.O., H. Parke D.S. County Road Commission Records - Monument
 Post Recorded Surveys -
 Hemlock 26", N10°E, 8 Links Case, 5-9-72, Liber 1, Page 194, Mon. box
 Fir 11", S16½°E, 32 Links Case, 8-23-78, Liber 3, Page 490, 5/8" steel pin in Mon. box
 Case, 8-23-78, Liber 3, Page 593, Mon. box in place.
 Case, 5-12-80, Liber 4, Page 289, Pin in Mon. Box in place.
 L.C.R.C. - NONE
 County Surveyor Records - Unrecorded Surveys - NONE
 November 19th, 1901
 May 11th, 1911
 Surveys show Corner


B. Description of corner evidence found and/or method applied in restoring or reestablishing corner:

M-1
 NE Cor, Section 1, T17N-R13E
 Found Monument Box
 Accepted as the best available evidence
 of original corner position
 (Intersection of Kinde and Verona Roads)

RECORDED
 FEB 13 2006
 SECTION

C. Description of monument for corner and accessories established to perpetuate locating the position of the corner:

M-1
 NE Cor, Section 1, T17N-R13E
 Set 1/2" Iron Bar in Monument Box (Capped)
 N45°E 61.60' to Nail in Telephone Pole
 N45°W 58.30' to Nail in Power Pole
 S45°E 61.40' to Nail in Telephone Pole
 S30°W 78.80' to Northeast Corner of Building
 S50°W 80.15' to Northwest Corner of Building
 West 2630.18' to S 1/4 Cor, Sec 36, T18N-R13E
 East 2500.47' to S 1/4 Cor, Sec 31, T18N-R14E

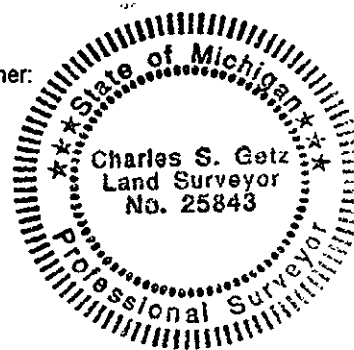

Signed by Charles S. Getz
 Surveyor's Michigan License No. 25843

Date August 14, 1999

PEER GROUP APPROVED AT MEETING
 HELD October 26, 1999. R.S.B.