

Common to:
 M01 - Lincoln Twp. - T17N-R13E
 M13 - Dwight Twp. - T18N-R13E
 A13 - Huron Twp. - T18N-R14E

Re Mon Liber 1, Page 266

1999 REMONUMENTATION

LAND CORNER RECORDATION CERTIFICATE
 Filing Requirement of Act 74, Mich. P.A. 1970

For corners in

<u>Huron</u> (County)	Located in:	Corner Code #
1. Public Land Survey	Bloomfield T17N R14E	A-1
	T R	
	T R	
	T R	
2. Property Controlling in Section	S T R	
	S T R	
3. Miscellaneous Property in Sec.	S T R	
	S T R	

STATE OF MICHIGAN
 HURON COUNTY
 RECORDED

28 OCT 99 9:18 A.M.

FRANCES L. HOLIDWICK
 REGISTER OF DEEDS

Register of Deeds Stamp & File Number

4. Lot No. _____, Recorded Plat _____
 5. Private Claims _____

I, Charles S. Getz, in a field survey on April 12, 1999 do hereby state that under requirements of P.A. 74, Michigan P.A. of 1970, the corner points mentioned in lines 1 and 2 above were in conformance with regulations and rules therefore as required in the current manual of survey instructions of the United States Department of the Interior, Bureau of Land Management or by a decree of a Court of Law and /or that the corner points mentioned in lines 3, 4 and 5 above were in conformance with the rules of the Michigan Board of Land Surveyors or by a Decree of a Court of Law, established, re-established, monumented, recovered, found as expressed below:

NOTE: Not more than 2 corners, all in the same town and range, may be recorded on this certificate.

1	A	B	C	D	E	F	G	H	I	J	K	L	M
2		6		5		4		3		2		1	
3													
4		7		8		9		10		11		12	
5													
6		18		17		16		15		14		13	
7													
8		19		20		21		22		23		24	
9													
10		30		29		28		27		26		25	
11													
12		31		32		33		34		35		36	
13													

A. Description of original monument and accessories and/or subsequent restoration:

A-1 1834 G.L.O., H. Parke D.S. Post Hemlock 26", N10°E, 8 Links Fir 11", S16½°E, 32 Links	County Road Commission Records - Monument Recorded Surveys - Case, 5-9-72, Liber 1, Page 194, Mon. box Case, 8-23-78, Liber 3, Page 490, 5/8" steel pin in Mon. box Case, 8-23-78, Liber 3, Page 593, Mon. box in place. Case, 5-12-80, Liber 4, Page 289, Pin in Mon. Box in place
L.C.R.C. - NONE	Unrecorded - NONE
County Surveyor Records - November 19th, 1901 May 11th, 1911 Surveys show Corner	


B. Description of corner evidence found and/or method applied in restoring or reestablishing corner:

A-1
 NW Cor, Section 6, T17N-R14E
 Found Monument Box
 Accepted as the best available evidence of original corner position
 (Intersection of Kinde and Verona Roads)

RECORDED
 FEB 17 2004
 SECTION

C. Description of monument for corner and accessories established to perpetuate locating the position of the corner:

A-1
 NW Cor, Section 6, T17N-R14E
 Set 1/2" Iron Bar in Monument Box (Capped)
 N45°E 61.60' to Nail in Telephone Pole
 N45°W 58.30' to Nail in Power Pole
 S45°E 61.40' to Nail in Telephone Pole
 S30°W 78.80' to Northeast Corner of Building
 S50°W 80.15' to Northwest Corner of Building
 West 2630.18' to S 1/4 Cor, Sec 36, T18N-R13E
 East 2500.47' to S 1/4 Cor, Sec 31, T18N-R14E

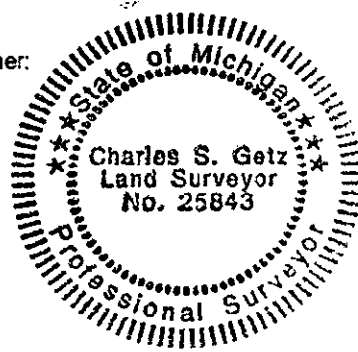

Signed by Charles S. Getz
 Surveyor's Michigan License No. 25843

Date August 14, 1999

PEER GROUP APPROVED AT MEETING
 HELD October 26, 1999 R.L.B.