

*Re-mon. Rod 1, Page 149*

REMONUMENTATION

LAND CORNER RECORDATION CERTIFICATE  
Filing Requirement of Act 74, Mich. P.A. 1970

For corners in

<u>Huron</u> (County)	Located In:	Corner Code #
1. Public Land Survey	Bloomfield T17N R14E	A-13
	T R	
	T R	
	T R	
2. Property Controlling in Section	S T R	
	S T R	
3. Miscellaneous Property in Sec.	S T R	
	S T R	

STATE OF MICHIGAN  
HURON COUNTY  
RECORDED

25 NOV 98 10:03 A.M.

FRANCES L. HOLDWICK  
REGISTER OF DEEDS

Register of Deeds Stamp & File Number

4. Lot No. \_\_\_\_\_, Recorded Plat \_\_\_\_\_  
5. Private Claims \_\_\_\_\_

I, Charles S. Getz, in a field survey on Oct. 30, 1998 do hereby state that under requirements of P.A. 74, Michigan P.A. of 1970, the corner points mentioned in lines 1 and 2 above were in conformance with regulations and rules therefore as required in the current manual of survey instructions of the United States Department of the Interior, Bureau of Land Management or by a decree of a Court of Law and /or that the corner points mentioned in lines 3, 4 and 5 above were in conformance with the rules of the Michigan Board of Land Surveyors or by a Decree of a Court of Law, established, re-established, monumented, recovered, found as expressed below:

NOTE: Not more than 2 corners, all in the same town and range, may be recorded on this certificate.

A	B	C	D	E	F	G	H	I	J	K	L	M
1												
2	6	5	4	3	2	1						
3												
4	7	8	9	10	11	12						
5												
6	18	17	16	15	14	13						
7												
8	19	20	21	22	23	24						
9												
10	30	29	28	27	26	25						
11												
12	31	32	33	34	35	36						
13												

A. Description of original monument and accessories and/or subsequent restoration:

A-13  
1834 G.L.O., H. Parke D.S.  
Post  
Beech 10", S49°E, 11 Links  
Hemlock 9", N31°W, 18 Links

County Surveyor Records - NONE  
County Road Commission Records - Iron Pin  
Recorded Surveys - Survey Liber 2, Page 375, 1 1/4" pipe in place.  
Survey Liber 3, Page 217, 1 1/4" pipe  
Survey Liber 3, Page 761, 1 1/4" Pipe over top of 3/4" steel pin in place.  
Unrecorded Surveys - Case Surveying, 1-29-92, P.K. nail over corner  
Case Surveying, 4-2-97, Fd. iron in place.  
Huron Surveying, 6-29-93, Fd 3/4" Steel Stake

L.C.R.C. - NONE

B. Description of corner evidence found and/or method applied in restoring or reestablishing corner:

A-13  
SW Cor, Section 31, T17N-R14E  
Found 1-1/4" Iron Pipe  
Accepted as the best available evidence of original corner position  
(Intersection of Rapson & Verona Roads)


SURVEY &  
REMONUMENTATION

JAN 28 1999

SECTION

C. Description of monument for corner and accessories established to perpetuate locating the position of the corner:

A-13  
SW Cor, Section 31, T17N-R14E  
Set 1/2" Re-Rod in Monument Box (Capped)  
N25°W 42.90' to Center of C.B.  
S40°W 51.95' to Nail in Power Pole  
S45°E 61.45' to Telephone Box  
N45°E 69.90' to Corner of Building  
West 2642.78' to S 1/4 Cor, Sec 36, T17N-R13E  
East 2713.68' to S 1/4 Cor, Sec 31, T17N-R14E

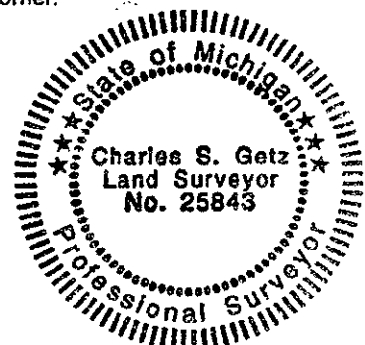

Signed by Charles S. Getz  
Surveyor's Michigan License No. 25843

Date October 31, 1998

PEER GROUP APPROVED AT  
MEETING BBB 11-24-98