

LAND CORNER RECORDATION CERTIFICATE
 Filing Requirement of Act 74, Mich. P.A. 1970

For corners in

<u>Huron</u> <small>(County)</small>	Located in:	Corner Code #	
1. Public Land Survey	Bloomfield	T17N R14E	C-13
		T R	
		T R	
		T R	
2. Property Controlling in Section	S	T R	
	S	T R	
3. Miscellaneous Property in Sec.	S	T R	
	S	T R	

STATE OF MICHIGAN
 HURON COUNTY
 RECORDED

25 NOV 98 10:03 A.M.

FRANCES L. HOLDWICK
 REGISTER OF DEEDS

Register of Deeds Stamp & File Number

4. Lot No. _____, Recorded Plat _____
 5. Private Claims _____

I, Charles S. Getz, in a field survey on Oct. 30, 1998 do hereby state that under requirements of P.A. 74, Michigan P.A. of 1970, the corner points mentioned in lines 1 and 2 above were in conformance with regulations and rules therefore as required in the current manual of survey instructions of the United States Department of the Interior, Bureau of Land Management or by a decree of a Court of Law and /or that the corner points mentioned in lines 3, 4 and 5 above were in conformance with the rules of the Michigan Board of Land Surveyors or by a Decree of a Court of Law; established, re-established, monumented, recovered, found as expressed below:

NOTE: Not more than 2 corners, all in the same town and range, may be recorded on this certificate.

	A	B	C	D	E	F	G	H	I	J	K	L	M
1													
2		6		5		4		3		2		1	
3													
4		7		8		9		10		11		12	
5													
6		10		17		16		15		14		13	
7													
8		19		20		21		22		23		24	
9													
10		30		29		28		27		26		25	
11													
12		31		32		33		34		35		36	
13													

A. Description of original monument and accessories and/or subsequent restoration:

C-13
 1834 G.L.O., H. Parke D.S.
 Aspin 16in Cor tree
 Aspin 10", N45°E, 20 Links
 Do. 13", N55½°W, 27½ Links

County Surveyor Records - May 3rd, 1894 - Grind stone
 County Road Commission Records - 5/8" Steel Pin
 Recorded Surveys - Survey Liber 1, Page 552, Found large stone with small stones around base in place. Raised with 1" bolt over point.

Unrecorded Surveys - NONE

L.C.R.C. - NONE

B. Description of corner evidence found and/or method applied in restoring or reestablishing corner:

C-13
 SW Cor, Section 32, T17N-R14E
 Found 1" Bolt
 Accepted as the best available evidence of original corner position
 (On Rapson Road)


SURVEY &
 REMONUMENTATION

JAN 28 1999

SECTION

C. Description of monument for corner and accessories established to perpetuate locating the position of the corner:

C-13
 SW Cor, Section 32, T17N-R14E
 Found 1" Bolt
 N45°E 39.40' to North End of Culvert
 S45°E 46.20' to South End of Culvert
 N05°W 27.00' to West End of Culvert
 N75°E 68.80' to East Leg of Road Sign
 East 65.80' to 3/4" Iron Bar
 West 2643.42' to S 1/4 Cor, Sec 31, T17N-R14E
 East 2628.78' to S 1/4 Cor, Sec 32, T17N-R14E

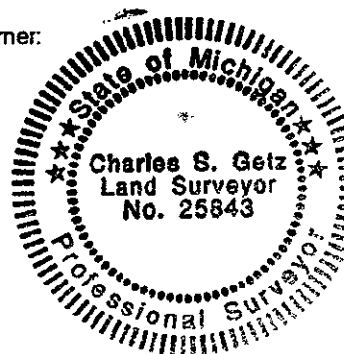

Signed by Charles S. Getz

Date October 31, 1998

Surveyor's Michigan License No. 25843

PEER GROUP APPROVED AT
 MEETING 11-24-98 RKB