

LAND CORNER RECORDATION CERTIFICATE
 Filing Requirement of Act 74, Mich. P.A. 1970

For corners in

<u>Huron</u> <small>(County)</small>	Located In:	Corner Code #
1. Public Land Survey	Bloomfield	T17NR14E D-13
		T___R___
		T___R___
		T___R___
2. Property Controlling in Section	S___	T___R___
	S___	T___R___
3. Miscellaneous Property in Sec.	S___	T___R___
	S___	T___R___

STATE OF MICHIGAN
 HURON COUNTY
 RECORDED

 25 NOV 98 10:03 A.M.

 FRANCES L. HOLDWICK
 REGISTER OF DEEDS

 Register of Deeds Stamp & File Number

4. Lot No. _____, Recorded Plat _____
 5. Private Claims _____

I, Charles S. Getz, in a field survey on Oct. 30, 1998 do hereby state that under requirements of P.A. 74, Michigan P.A. of 1970, the corner points mentioned in lines 1 and 2 above were in conformance with regulations and rules therefore as required in the current manual of survey instructions of the United States Department of the Interior, Bureau of Land Management or by a decree of a Court of Law and /or that the corner points mentioned in lines 3, 4 and 5 above were in conformance with the rules of the Michigan Board of Land Surveyors or by a Decree of a Court of Law, established, re-established, monumented, recovered, found as expressed below:

A	B	C	D	E	F	G	H	I	J	K	L	M
1												
2	6	5	4	3	2	1						
3												
4	7	8	9	10	11	12						
5												
6	18	17	16	15	14	13						
7												
8	19	20	21	22	23	24						
9												
10	30	29	28	27	26	25						
11												
12	31	32	33	34	35	36						
13												

NOTE: Not more than 2 corners, all in the same town and range, may be recorded on this certificate.

A. Description of original monument and accessories and/or subsequent restoration:
 D-13
 1834 G.L.O., H. Parke D.S. County Surveyor Records - May 3rd, 1894 - Cedar Post
 Set quarter section post County Road Commission Records - 5/8" Iron Pin
 Fir 10", N79°E, 26 Links Recorded Surveys - Survey Liber 1, Page 552, 3/4" iron pin in place.
 Tamarack 6", N41½°W, 9½ Links Unrecorded Surveys - NONE

 L.C.R.C. - NONE


B. Description of corner evidence found and/or method applied in restoring or reestablishing corner:
 D-13
 S 1/4 Cor, Section 32, T17N-R14E
 Found 3/4" Iron Bar
 Accepted as the best available evidence of original corner position
 (On Rapson Road)

SURVEY &
 REMONUMENTATION

JAN 28 1999

SECTION

C. Description of monument for corner and accessories established to perpetuate locating the position of the corner:
 D-13
 S 1/4 Cor, Section 32, T17N-R14E
 Found 3/4" Iron Bar
 N05°E 32.20' to Concrete Fence Post
 N70°E 79.30' to Nail in Power Pole
 N35°W 31.60' to West End of C.M.P.
 West 2628.78' to SW Cor, Sec 32, T17N-R14E
 East 2627.68' to SE Cor, Sec 32, T17N-R14E

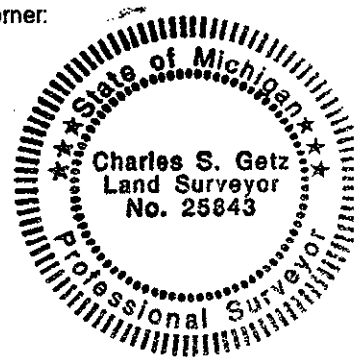

Signed by Charles S. Getz
 Surveyor's Michigan License No. 25843

Date October 31, 1998

PEER GROUP APPROVED AT
 MEETING 11-24-98 *R&B*