

LAND CORNER RECORDATION CERTIFICATE
Filing Requirement of Act 74, Mich. P.A. 1970

For corners in

<u>Huron</u>	Located In:	Corner Code #	
(County)			
1. Public Land Survey	Bloomfield	T <u>17</u> N R <u>14</u> E	<u>F-13</u>
		T ___ R ___	_____
		T ___ R ___	_____
		T ___ R ___	_____
2. Property Controlling in Section	S ___	T ___ R ___	_____
	S ___	T ___ R ___	_____
3. Miscellaneous Property in Sec.	S ___	T ___ R ___	_____
	S ___	T ___ R ___	_____

STATE OF MICHIGAN
HURON COUNTY
RECORDED

25 NOV 98 10:04 A.M.

FRANCES L. HOLDWICK
REGISTER OF DEEDS

Register of Deeds Stamp & File Number

4. Lot No. _____, Recorded Plat _____
5. Private Claims _____

I, Charles S. Getz, in a field survey on Oct. 30, 1998 do hereby state that under requirements of P.A. 74, Michigan P.A. of 1970, the corner points mentioned in lines 1 and 2 above were in conformance with regulations and rules therefore as required in the current manual of survey instructions of the United States Department of the Interior, Bureau of Land Management or by a decree of a Court of Law and /or that the corner points mentioned in lines 3, 4 and 5 above were in conformance with the rules of the Michigan Board of Land Surveyors or by a Decree of a Court of Law; established, re-established, monumented, recovered, found as expressed below:

NOTE: Not more than 2 corners, all in the same town and range, may be recorded on this certificate.

1	A	B	C	D	E	F	G	H	I	J	K	L	M
2	6		5		4		3		2		1		
3													
4	7		8		9		10		11		12		
5													
6	18		17		16		15		14		13		
7													
8	19		20		21		22		23		24		
9													
10	30		29		28		27		26		25		
11													
12	31		32		33		34		35		36		
13													

A. Description of original monument and accessories and/or subsequent restoration:

F-13 1834 G.L.O., H. Parke D.S. Set quarter section post Cedar 16", N17°W, 31½ Links Hemlock 7", N88°E, 19 Links	County Surveyor Records - August 25th, 1887 - quarter section post was set at equidistances from section Corners. County Road Commission Records - Iron Bar Recorded Surveys - NONE Unrecorded Surveys - Huron Surveying, 3-13-98, Found 5/8" Re-Rod
--	---

L.C.R.C. - NONE

B. Description of corner evidence found and/or method applied in restoring or reestablishing corner:

F-13
S 1/4 Cor, Section 33, T17N-R14E
Found 5/8" Re-Rod, Raised with 1/2" Iron Bar
Accepted as the best available evidence of original corner position
(On Rapson Road)


**SURVEY &
REMONUMENTATION**

JAN 28 1999

SECTION

C. Description of monument for corner and accessories established to perpetuate locating the position of the corner:

F-13
S 1/4 Cor, Section 33, T17N-R14E
Found 5/8" Re-Rod, Raised with 1/2" Iron Bar
N25°W 49.15' to Spike in W. Side of 28" Twin Ash
North 38.14' to Spike in W. Side of 12" Ash Tree
West 2622.00' to SW Cor, Sec 33, T17N-R14E
East 2623.58' to SE Cor, Sec 33, T17N-R14E

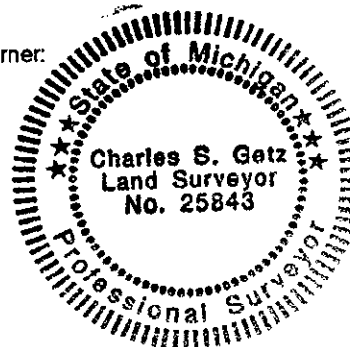

Signed by Charles S. Getz
Surveyor's Michigan License No. 25843

Date October 31, 1998

PEER GROUP APPROVED AT
MEETING 11-24-98 RRB