

LAND CORNER RECORDATION CERTIFICATE
 Filing Requirement of Act 74, Mich. P.A. 1970

For corners in

Huron	Located In:	Corner Code #	
(County)			
1. Public Land Survey	Bloomfield	T17N R14E	G-13
		T___ R___	_____
		T___ R___	_____
		T___ R___	_____
2. Property Controlling in Section	S___	T___ R___	_____
	S___	T___ R___	_____
3. Miscellaneous Property in Sec.	S___	T___ R___	_____
	S___	T___ R___	_____

STATE OF MICHIGAN
 HURON COUNTY
 RECORDED

25 NOV 98 10:04 A.M.

FRANCES L. HOLDWICK
 REGISTER OF DEEDS

Register of Deeds Stamp & File Number

4. Lot No. _____, Recorded Plat _____
 5. Private Claims _____

I, Charles S. Getz, in a field survey on Oct. 30, 1998 do hereby state that under requirements of P.A. 74, Michigan P.A. of 1970, the corner points mentioned in lines 1 and 2 above were in conformance with regulations and rules therefore as required in the current manual of survey instructions of the United States Department of the Interior, Bureau of Land Management or by a decree of a Court of Law and for that the corner points mentioned in lines 3, 4 and 5 above were in conformance with the rules of the Michigan Board of Land Surveyors or by a Decree of a Court of Law; established, re-established, monumented, recovered, found as expressed below:

NOTE: Not more than 2 corners, all in the same town and range, may be recorded on this certificate.

	A	B	C	D	E	F	G	H	I	J	K	L	M
1													
2	6		5			4		3		2		1	
3													
4	7		8			9		10		11		12	
5													
6	18		17			16		15		14		13	
7													
8	19		20			21		22		23		24	
9													
10	30		29			28		27		26		25	
11													
12	31		32			33		34		35		36	
13													

A. Description of original monument and accessories and/or subsequent restoration:

G-13
 1834 G.L.O., H. Parke D.S.
 Set post
 Maple 17", N53°W, 19 Links
 Hemlock 10", N61°E, 7 Links

County Surveyor Records - August 25th, 1887 - South East Corner was reestablished from the Nearest Known Corners at Proportional distances (Survey of Section 33)
 County Road Commission Records - Iron Pin in Post - Stones around Recorded Surveys - NONE
 Unrecorded Surveys - Case Surveying, 7-23-86, Fd. 3/4" steel pin. Huron Surveying, 3-13-98, Found 5/8" Re-Rod

L.C.R.C. - NONE

B. Description of corner evidence found and/or method applied in restoring or reestablishing corner:

G-13
 SW Cor, Section 34, T17N-R14E
 Found 5/8" Re-Rod
 Accepted as the best available evidence of original corner position
 (Intersection of Rapson & Johnston Roads)


**SURVEY &
 REMONUMENTATION**

JAN 28 1999

SECTION

C. Description of monument for corner and accessories established to perpetuate locating the position of the corner:

G-13
 SW Cor, Section 34, T17N-R14E
 Found 5/8" Re-Rod
 N45°W 44.15' to East Leg of Road Sign
 S30°E 38.20' to Nail in Power Pole
 S20°W 29.60' to East Leg of Road Sign
 S75°W 69.50' to South End of C.M.P.
 West 2623.58' to S 1/4 Cor, Sec 33, T17N-R14E
 East 2639.06' to S 1/4 Cor, Sec 34, T17N-R14E

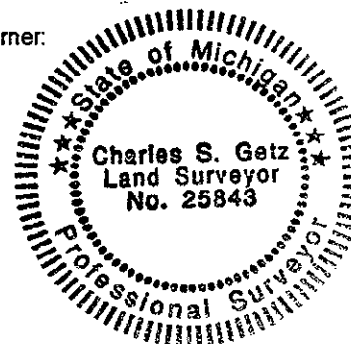

Signed by Charles S. Getz
 Surveyor's Michigan License No. 25843

Date November 8, 1998

PEER GROUP APPROVED AT
 MEETING 11-24-98 R&B