

LAND CORNER RECORDATION CERTIFICATE
 Filing Requirement of Act 74, Mich. P.A. 1970

For corners in

<u>Huron</u> (County)	Located In:	Corner Code #	
1. Public Land Survey	Bloomfield	T <u>17</u> N <u>14</u> E	<u>I-13</u>
		T ___ R ___	_____
		T ___ R ___	_____
		T ___ R ___	_____
2. Property Controlling in Section	S ___	T ___ R ___	_____
	S ___	T ___ R ___	_____
3. Miscellaneous Property in Sec.	S ___	T ___ R ___	_____
	S ___	T ___ R ___	_____

STATE OF MICHIGAN
 HURON COUNTY
 RECORDED

25 NOV 98 10:04 A.M.

FRANCES L. HOLDWICK
 REGISTER OF DEEDS

Register of Deeds Stamp & File Number

4. Lot No. _____, Recorded Plat _____
 5. Private Claims _____

I, Charles S. Getz, in a field survey on Nov. 04, 1998 do hereby state that under requirements of P.A. 74, Michigan P.A. of 1970, the corner points mentioned in lines 1 and 2 above were in conformance with regulations and rules therefore as required in the current manual of survey instructions of the United States Department of the Interior, Bureau of Land Management or by a decree of a Court of Law and /or that the corner points mentioned in lines 3, 4 and 5 above were in conformance with the rules of the Michigan Board of Land Surveyors or by a Decree of a Court of Law; established, re-established, monumented, recovered, found as expressed below:

NOTE: Not more than 2 corners, all in the same town and range, may be recorded on this certificate.

	A	B	C	D	E	F	G	H	I	J	K	L	M
1													
2	6		5		4		3		2		1		
3													
4	7		8		9		10		11		12		
5													
6	18		17		16		15		14		13		
7													
8	19		20		21		22		23		24		
9													
10	30		29		28		27		26		25		
11													
12	31		32		33		34		35		36		
13													

A. Description of original monument and accessories and/or subsequent restoration:

I-13	County Surveyor Records - NONE
1834 G.L.O., H. Parke D.S.	County Road Commission Records - Ford Axle
Set post	Recorded Surveys - Survey Liber 3, Page 601, Found Axle Shaft
B. Ash 8", N63½°E, 18 Links	Unrecorded Surveys - Huron Surveying, 6-26-95, Found 1 1/4" Steel Bar
Do. 8", N60°W, 17 Links	Huron Surveying, 6-12-97, Found Axle Shaft
	Case Surveying, 9-18-97, Fd. Axle Shaft in place.

L.C.R.C. - NONE

B. Description of corner evidence found and/or method applied in restoring or reestablishing corner:

I-13
 SW Cor, Section 35, T17N-R14E
 Found Axle Shaft
 Accepted as the best available evidence of original corner position
 (Intersection of Rapson & Parisville Roads)


**SURVEY &
 REMONUMENTATION**

JAN 28 1999

SECTION

C. Description of monument for corner and accessories established to perpetuate locating the position of the corner:

I-13
 SW Cor, Section 35, T17N-R14E
 Found Axle Shaft
 South 13.0' to West Leg of Road Sign
 N30°W 42.75' to Stop Sign
 N40°E 50.80' to Nail in Fence Post
 S20°W 28.90' to East End of C.M.P.
 S15°W 55.80' to Nail in Power Pole
 West 76.86' to 1" Iron Bar
 West 2628.86' to S 1/4 Cor, Sec 34, T17N-R14E
 East 2629.76' to S 1/4 Cor, Sec 35, T17N-R14E

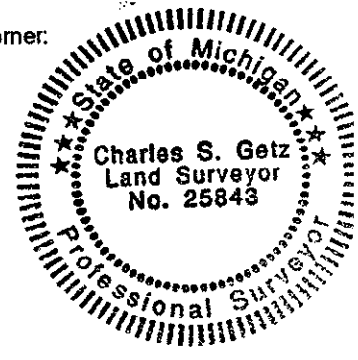

Signed by Charles S. Getz
 Surveyor's Michigan License No. 25843

Date November 8, 1998

PEER GROUP APPROVED AT
 MEETING 11-24-98 RLB