

Common to:
 M13 - Huron Twp. - T18N-R14E
 A13 - Gore Twp. - T18N-R15E
 A01 - Rubicon Twp. - T17N-R15E

R. Mon Liber 1, Page 267

1999 REMONUMENTATION

LAND CORNER RECORDATION CERTIFICATE
 Filing Requirement of Act 74, Mich. P.A. 1970

For corners in

<u>Huron</u> (County)	Located In:	Corner Code #
1. Public Land Survey Bloomfield	T <u>17</u> N R <u>14</u> E	<u>M-1</u>
	T ___ R ___	_____
	T ___ R ___	_____
	T ___ R ___	_____
2. Property Controlling in Section	S ___ T ___ R ___	_____
	S ___ T ___ R ___	_____
3. Miscellaneous Property in Sec.	S ___ T ___ R ___	_____
	S ___ T ___ R ___	_____

STATE OF MICHIGAN
 HURON COUNTY
 RECORDED

28 OCT 99 9:18 A.M.

FRANCES L. HOLDWICK
 REGISTER OF DEEDS

Register of Deeds Stamp & File Number

4. Lot No. _____, Recorded Plat _____
 5. Private Claims _____

	A	B	C	D	E	F	G	H	I	J	K	L	M	
1														
2	6			5			4			3			2	1
3														
4	7			8			9			10			11	12
5														
6	18			17			16			15			14	13
7														
8	19			20			21			22			23	24
9														
10	30			29			28			27			26	25
11														
12	31			32			33			34			35	36
13														

I, Charles S. Getz, in a field survey on April 14, 1999 do hereby state that under requirements of P.A. 74, Michigan P.A. of 1970, the corner points mentioned in lines 1 and 2 above were in conformance with regulations and rules therefore as required in the current manual of survey instructions of the United States Department of the Interior, Bureau of Land Management or by a decree of a Court of Law and/or that the corner points mentioned in lines 3, 4 and 5 above were in conformance with the rules of the Michigan Board of Land Surveyors or by a Decree of a Court of Law; established, re-established, monumented, recovered, found as expressed below:

NOTE: Not more than 2 corners, all in the same town and range, may be recorded on this certificate.

A. Description of original monument and accessories and/or subsequent restoration:

M-1 1834 G.L.O., H. Parke D.S. Post Hemlock 14", N85°E, 9 Links Beech 11", N76°W, 24 Links	County Road Commission Records - Iron Pin in Post Recorded Surveys - Case, 1-20-72, Liber 1, Page 130, Iron Pin Case, 8-3-73, Liber 1, Page 523, P.K. nail over steel pin
L.C.R.C. - NONE	Unrecorded Surveys - Brown, 5-17-93, 3/4" Re-Rod in Mon. Box Brown, 8-10-94, 3/4" Steel Stake in Monument Box
County Surveyor Records - April 18th, 1884 January 7, 1893 Surveys show Corner	


B. Description of corner evidence found and/or method applied in restoring or reestablishing corner:

M-1
 NE Cor, Section 1, T17N-R14E
 Found 3/4" Iron Bar in Monument Box
 Accepted as the best available evidence
 of original corner position
 (Intersection of Kinde & Finkel Roads)

REMONUMENTATION
 FEB 11 2000
 SECTION

C. Description of monument for corner and accessories established to perpetuate locating the position of the corner:

M-1
 NE Cor, Section 1, T17N-R14E
 Found 3/4" Iron Bar in Monument Box
 N30°W 71.95' to Nail in Power Pole
 N35°W 59.25' to Nail in Telephone Pole
 S20°W 58.32' to Nail in Ash Tree
 West 2641.27' to S 1/4 Cor, Sec 36, T18N-R14E
 East 2645.87' to S 1/4 Cor, Sec 31, T18N-R15E
 S20°E 43.20' to Stop Sign

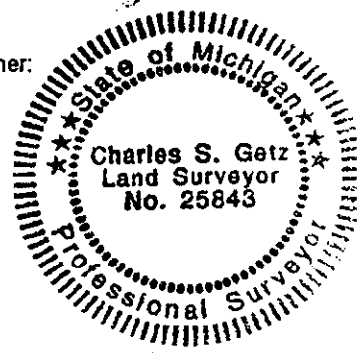

Signed by Charles S. Getz
 Surveyor's Michigan License No. 25843

Date August 21, 1999

PEER GROUP APPROVED AT MEETING
 HELD October 26, 1999 *R.L.B.*