

Common to:  
 M01 - Bloomfield Twp. - T17N-R14E  
 M13 - Huron Twp. - T18N-R14E  
 A13 - Gore Twp. - T18N-R15E

*Re Mon Liber 1, Page 268*

1999 REMONUMENTATION

LAND CORNER RECORDATION CERTIFICATE  
 Filing Requirement of Act 74, Mich. P.A. 1970

For corners in

Huron (County)	Located In:	Corner Code #
1. Public Land Survey	Rubicon T17NR15E	A-1
	T R	
	T R	
	T R	
2. Property Controlling in Section	S T R	
	S T R	
3. Miscellaneous Property in Sec.	S T R	
	S T R	

STATE OF MICHIGAN  
 HURON COUNTY  
 RECORDED

28 OCT 99 9:19 A.M.

FRANCES L. HOLDWICK  
 REGISTER OF DEEDS

Register of Deeds Stamp & File Number

4. Lot No. \_\_\_\_\_, Recorded Plat \_\_\_\_\_  
 5. Private Claims \_\_\_\_\_

1	A	B	C	D	E	F	G	H	I	J	K	L	M
2		6		5		4		3		2		1	
3													
4		7		8		9		10		11		12	
5													
6		18		17		16		15		14		13	
7													
8		19		20		21		22		23		24	
9													
10		30		29		28		27		26		25	
11													
12		31		32		33		34		35		36	
13													

I, Charles S. Getz, in a field survey on April 14, 1999 do hereby state that under requirements of P.A. 74, Michigan P.A. of 1970, the corner points mentioned in lines 1 and 2 above were in conformance with regulations and rules therefore as required in the current manual of survey instructions of the United States Department of the Interior, Bureau of Land Management or by a decree of a Court of Law and /or that the corner points mentioned in lines 3, 4 and 5 above were in conformance with the rules of the Michigan Board of Land Surveyors or by a Decree of a Court of Law, established, re-established, monumented, recovered, found as expressed below.

NOTE: Not more than 2 corners, all in the same town and range, may be recorded on this certificate.

A. Description of original monument and accessories and/or subsequent restoration:

A-1 1834 G.L.O., H. Parke D.S.  
 Post  
 Henlock 14", N85°E, 9 Links  
 Beech 11", N76°W, 24 Links

County Road Commission Records - Iron Pin in Post  
 Recorded Surveys -  
 Case, 1-20-72, Liber 1, Page 130, Iron Pin  
 Case, 8-3-73, Liber 1, Page 523, P.K. nail over steel pin

L.C.R.C. - NONE

Unrecorded Surveys -  
 Brown, 5-17-93, 3/4" Re-Rod in Mon. Box  
 Brown, 8-10-94, 3/4" Steel Stake in Monument Box

B. Description of corner evidence found and/or method applied in restoring or reestablishing corner:

A-1  
 NW Cor, Section 6, T17N-R15E  
 Found 3/4" Iron Bar in Monument Box  
 Accepted as the best available evidence  
 of original corner position  
 (Intersection of Kinde & Finkel Roads)


REMONUMENTATION

FEB 18 2000

SECTION

C. Description of monument for corner and accessories established to perpetuate locating the position of the corner:

A-1  
 NW Cor, Section 6, T17N-R15E  
 Found 3/4" Iron Bar in Monument Box  
 N30°W 71.95' to Nail in Power Pole  
 N35°W 59.25' to Nail in Telephone Pole  
 S20°W 58.32' to Nail in Ash Tree  
 S20°E 43.20' to Stop Sign  
 West 2641.27' to S 1/4 Cor, Sec 36, T18N-R14E  
 East 2645.87' to S 1/4 Cor, Sec 31, T18N-R15E

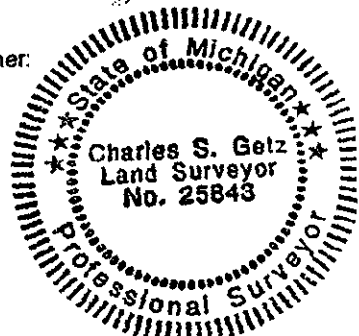

Signed by Charles S. Getz  
 Surveyor's Michigan License No. 25843

Date August 21, 1999

PEER GROUP APPROVED AT MEETING  
 HELD October 26, 1999 R.S.B.