

Re-mon. Lidw 1, Page 165

REMONUMENTATION

LAND CORNER RECORDATION CERTIFICATE  
Filing Requirement of Act 74, Mich. P.A. 1970

For corners in

<u>Huron</u> (County)	Located In:	Corner Code #
1. Public Land Survey	Rubicon T17NR15E	D-13
	T___ R___	_____
	T___ R___	_____
	T___ R___	_____
2. Property Controlling in Section	S___ T___ R___	_____
	S___ T___ R___	_____
3. Miscellaneous Property in Sec.	S___ T___ R___	_____
	S___ T___ R___	_____

STATE OF MICHIGAN  
HURON COUNTY  
RECORDED

25 NOV 98 10:06 A.M.

FRANCES L. HOLDWICK  
REGISTER OF DEEDS

Register of Deeds Stamp & File Number

4. Lot No. \_\_\_\_\_, Recorded Plat \_\_\_\_\_  
5. Private Claims \_\_\_\_\_

I, Charles S. Getz, in a field survey on Nov. 12, 1998 do hereby state that under requirements of P.A. 74, Michigan P.A. of 1970, the corner points mentioned in lines 1 and 2 above were in conformance with regulations and rules therefore as required in the current manual of survey instructions of the United States Department of the Interior, Bureau of Land Management or by a decree of a Court of Law and /or that the corner points mentioned in lines 3, 4 and 5 above were in conformance with the rules of the Michigan Board of Land Surveyors or by a Decree of a Court of Law; established, re-established, monumented, recovered, found as expressed below:

NOTE: Not more than 2 corners, all in the same town and range, may be recorded on this certificate.

	A	B	C	D	E	F	G	H	I	J	K	L	M
1													
2		6		5		4		3		2		1	
3													
4		7		8		9		10		11		12	
5													
6		18		17		16		15		14		13	
7													
8		19		20		21		22		23		24	
9													
10		30		29		28		27		26		25	
11													
12		31		32		33		34		35		36	
13													

A. Description of original monument and accessories and/or subsequent restoration:

D-13  
1834 G.L.O., H. Parke D.S.  
Set quarter section post  
Birch 7", N50°W, 7 Links  
Maple 14", N36½°E, 27 Links

County Surveyor Records - NONE

County Road Commission Records - Monument Iron Pin  
between Stones

Recorded Surveys - NONE

Unrecorded Surveys - NONE

L.C.R.C. - NONE

B. Description of corner evidence found and/or method applied in restoring or reestablishing corner:

D-13  
S 1/4 Cor, Section 32, T17N-R15E  
Found no evidence of original corner position.  
Re-established corner position by proportionate measure  
from G.L.O. Notes, between E-13 and C-13 as best  
evidence of original corner position for D-13.  
(On Rapson Road)


SURVEY &  
REMONUMENTATION

JAN 28 1999

SECTION

C. Description of monument for corner and accessories established to perpetuate locating the position of the corner:

D-13  
S 1/4 Cor, Section 32, T17N-R15E  
Set 1/2" Re-Rod in Monument Box (Capped)  
South 0.50' to Centerline of Road  
N15°E 61.75' to Nail in 24" Pine  
N45°E 92.50' to Nail in Power Pole  
N60°E 95.90' to Telephone Box  
West 2633.64' to SW Cor, Sec 32, T17N-R15E  
East 2633.64' to SE Cor, Sec 32, T17N-R15E

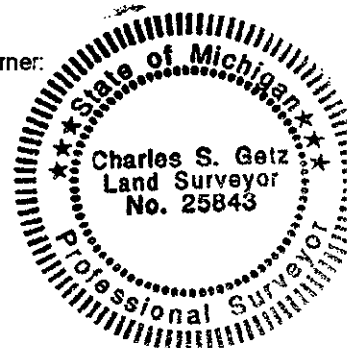

Signed by Charles S. Getz  
Surveyor's Michigan License No. 25843

Date November 15, 1998

PEER GROUP APPROVED AT  
MEETING 11-24-98 RLB