

Re-Mon., Liber 1, Page 172

REMONUMENTATION

LAND CORNER RECORDATION CERTIFICATE  
Filing Requirement of Act 74, Mich. P.A. 1970

For corners in

Huron (County)	Located In:	Corner Code #
1. Public Land Survey	Rubicon T17N R15E	K-13
	T R	
	T R	
	T R	
2. Property Controlling in Section	S T R	
	S T R	
3. Miscellaneous Property in Sec.	S T R	
	S T R	

STATE OF MICHIGAN  
HURON COUNTY  
RECORDED

25 NOV 98 10:07 A.M.

FRANCES L. HOLDWICK  
REGISTER OF DEEDS

Register of Deeds Stamp & File Number

4. Lot No. \_\_\_\_\_, Recorded Plat \_\_\_\_\_  
5. Private Claims \_\_\_\_\_

I, Charles S. Getz, in a field survey on Nov. 12, 1998 do hereby state that under requirements of P.A. 74, Michigan P.A. of 1970, the corner points mentioned in lines 1 and 2 above were in conformance with regulations and rules therefore as required in the current manual of survey instructions of the United States Department of the Interior, Bureau of Land Management or by a decree of a Court of Law and /or that the corner points mentioned in lines 3, 4 and 5 above were in conformance with the rules of the Michigan Board of Land Surveyors or by a Decree of a Court of Law; established, re-established, monumented, recovered, found as expressed below:

NOTE: Not more than 2 corners, all in the same town and range, may be recorded on this certificate.

	A	B	C	D	E	F	G	H	I	J	K	L
1												
2	6		5		4		3		2		1	
3												
4	7		8		9		10		11		12	
5												
6	18		17		16		15		14		13	
7												
8	19		20		21		22		23		24	
9												
10	30		29		28		27		26		25	
11												
12	31		32		33		34		35		36	
13												

A. Description of original monument and accessories and/or subsequent restoration:

K-13 Set Post  
1834 G.L.O., H. Parke D.S.  
Cedar 14", N17 1/2°W, 5 Links  
B. Ash 7", N40°E, 15 1/2 Links

County Surveyor Records - NONE  
County Road Commission Records - Axle Shaft  
Recorded Surveys - NONE  
Unrecorded Surveys - NONE

L.C.R.C. - NONE

B. Description of corner evidence found and/or method applied in restoring or reestablishing corner:

K-13  
SW Cor, Section 36, T17N-R15E  
Found no evidence of original corner position.  
Re-established corner position by using G.L.O.  
offset from NW Cor, Sec 1, T16N-R15E as best  
evidence of original corner position for K-13.  
(On Rapson Road)


SURVEY &  
REMONUMENTATION

JAN 28 1999

SECTION

C. Description of monument for corner and accessories established to perpetuate locating the position of the corner:

K-13  
SW Cor, Section 36, T17N-R15E  
Set 1/2" Re-Rod (Capped)  
S05°W 32.45' to Nail in 24" Maple  
S35°W 35.55' to Nail in 12" Maple  
S10°E 71.25' to Nail in 24" Apple Tree  
West 262.02' to 3/4" Pipe  
East 2167.30' to 1/2" Re-Rod, Witness Corner to the G.L.O.  
Meander Cor, Sec 36, T17N-R15E  
West 2625.28' to S 1/4 Cor, Sec 35, T17N-R15E

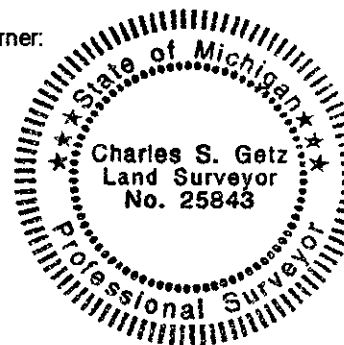

Signed by Charles S. Getz

Date November 15, 1998

Surveyor's Michigan License No. 25843

PEER GROUP APPROVED AT  
MEETING 11-24-98 RLB