

Common to:

- A13 - Lake Twp. - T18N-R11E
- A01 - Chandler Twp. - T17N-R11E
- M01 - Caseville Twp. - T17N-R10E

Re-Mon. Liber 2, Page 1

1999 REMONUMENTATION

LAND CORNER RECORDATION CERTIFICATE
Filing Requirement of Act 74, Mich. P.A. 1970

For Corners in

<u>Huron</u> (County)	Located in:	Corner Code #
1. Public Land survey: Caseville	T 18_N_ R 10_E	M-13
	T _____ R _____	_____
	T _____ R _____	_____
	T _____ R _____	_____
2. Property Controlling in Section	S _____ T _____ R _____	_____
	S _____ T _____ R _____	_____
3. Miscellaneous Property in Sec.	S _____ T _____ R _____	_____
	S _____ T _____ R _____	_____
4. Lot No. _____, Recorded Plat _____		
5. Private Claims _____		

RECORDED

DEC 28 4 18 PM '99

Frances Holmick
 REGISTER OF DEEDS
 HURON COUNTY, MICHIGAN

Register of Deeds Stamp & File Number

A	B	C	D	E	F	G	H	I	J	K	L	M
2	6		5		4		3		2		1	
3												
4	7		8		9		10		11		12	
5												
6	18		17		16		15		14		13	
7												
8	19		20		21		22		23		24	
9												
10	30		29		28		27		26		25	
11												
12	31		32		33		34		35		36	
13												

I, James T. Meek, in a field survey on October 30, 1999, do hereby certify that under requirements of P.A. 74, Michigan P.A. of 1970, the corner points mentioned in lines 1 and 2 above were in conformance with regulations and rules thereof as required in the current manual of survey instructions of the United States Department of the Interior, Bureau of Land Management or by a decree of a Court of Law and/or that the corner points mentioned in lines 3, 4 and 5 above were in conformance with the rules of the Michigan Board of Land Surveyors or by a Decree of a Court of Law; established, re-established, monumented, re-monumented, recovered, found as expressed below:

NOTE: Not more than 2 corners, all in the same town and range, may be recorded on this certificate.

A. Description of original monument and accessories and/or subsequent restoration:
 Original survey, South Bdy. T18NR10E, 1835, Harvey Parke D.S.
 M-13 Corner of Townships 17 and 18 North, Ranges 10 and 11 East
 Post
 White Ash 10", S14½°W, 74 links
 Maple 22", N44°E, 51 links


County Surveyor's Record: none
 Recorded Surveys: none
 LCRC: none

RECORDED
 FEB 10 2006
 SECTION

B. Description of corner evidence found and/or method applied in restoring or reestablishing corner:
 M-13 Corner of Townships 17 and 18 North, Ranges 10 and 11 East
 Found 2" pipe extending 1' above ground
 Accepted as the best available evidence of the original corner position.

C. Description of monument for corner and accessories established to perpetuate locating the position of the corner:
 M-13 Corner of Townships 17 and 18 North, Ranges 10 and 11 East

2" pipe extending 1' above ground
 From which:
 Tag in 14" walnut bears S10°W, 36.2'
 Tag in 24" maple bears S60°W, 53.0'
 Tag in 14" triple maple bears N85°E, 19.4'
 Tag in 12" maple bears S70°E, 27.6'

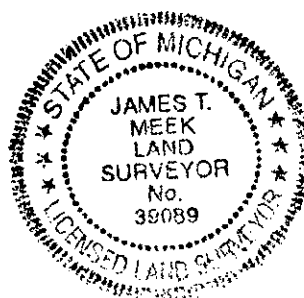

Signed by [Signature] Date 12-21-99
 Surveyor's Michigan License No. 39089

APPROVED AT PEER BOARD MEETING Dec 16, 1999 RLB