Re-Mon. Liber 2, Page 9

1999 REMONUMENTATION

LAND CORNER RECORDATION CERTIFICATE

Filing Requirement of Act 74, Mich. P.A. 1970

RECORDED

DEC 28 4 19 PM '99

Frances Hoffmeister
REGISTER OF DEEDS
HURON COUNTY, MICHIGAN

Register of Deeds Stamp & File Number

For Corners in
Huron
(County)

	Located in:	Corner Code #
1. Public Land survey: Lake	T 18_N_ R 11_E	J-13
	T____ R____	K-13
	T____ R____	
	T____ R____	
2. Property Controlling	S ____ T____ R____	
in Section	S ____ T____ R____	
3. Miscellaneous	S ____ T____ R____	
Property in Sec.	S ____ T____ R____	

4. Lot No. _____, Recorded Plat _____
5. Private Claims _____

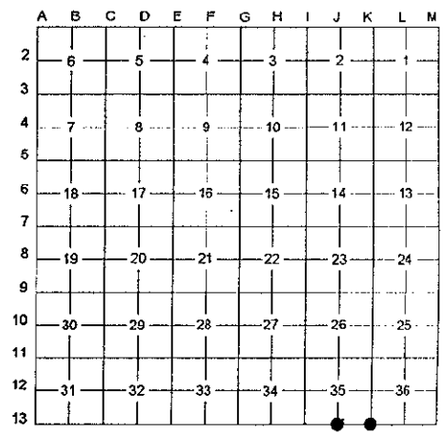

I, James T. Meek, in a field survey on October 30, 1999, do hereby certify that under requirements of P.A. 74, Michigan P.A. of 1970, the corner points mentioned in lines 1 and 2 above were in conformance with regulations and rules thereof as required in the current manual of survey instructions of the United States Department of the Interior, Bureau of Land Management or by a decree of a Court of Law and/or that the corner points mentioned in lines 3, 4 and 5 above were in conformance with the rules of the Michigan Board of Land Surveyors or by a Decree of a Court of Law; established, re-established, monumented, re-monumented, recovered, found as expessed below:

NOTE: Not more than 2 corners, all in the same town and range, may be recorded on this certificate.

A. Description of original monument and accessories and/or subsequent restoration:

Original survey, South Bdy. T18NR11E, 1835, Harvey Parke D.S.

J-13 South ¼ Corner of Section 35
Post
Hemlock 28", N81°E, 23 links
Hemlock 8", N72½°W, 15 links
County Surveyor's Record: iron rod over post
Recorded Surveys: L1, P541
LCRC: none

K-13 Corner of Sections 35 and 36
Post
Birch 10", N74½°E, 27 links
Cedar 12", N38°W, 9 links

County Surveyor's Record: 1"sq. iron
Recorded Surveys: none
LCRC: none

B. Description of corner evidence found and/or method applied in restoring or reestablishing corner:

J-13 South ¼ Corner of Section 35

Found ¾" iron in mon box
Occupation line bears North

Accepted as the best available evidence of the original corner position.

K-13 Corner of Sections 35 and 36

Found 1" pipe at intersection of Kinde & Champagne Roads
Accepted as the best available evidence of the original corner position.

C. Description of monument for corner and accessories established to perpetuate locating the position of the corner:

J-13 South ¼ Corner of Section 35

¾" iron in mon box

From which:
¾" iron in mon box bears East, 17.85'
Tag in power pole bears North, 53.3'
Tag in corner fence post bears S20°E, 37.5'
Phone box bears N5°E, 31.0'

K-13 Corner of Sections 35 and 36

1" pipe in mon box

From which:
Phone box bears N30°E, 54.6'
Stop sign post bears S30°E, 43.1'
½" iron bears S20°W, 35.0'
Tag in power pole bears N50°W, 77.9'

Signed by _____ Date 12-21-99

Surveyor's Michigan License No. 39089

APPROVED AT PEER BOARD MEETING 12-16-99 RLB

STATE OF MICHIGAN
JAMES T. MEEK
LAND SURVEYOR
No. 39089
LICENSED LAND SURVEYOR

FORM APPROVED BY MICHIGAN BOARD OF LAND SURVEYORS, JAN. 28, 1971
REVISED MAY 14, 1975
REVISED JAN., 1983
REVISED OCT., 1995