

LAND CORNER RECORDATION CERTIFICATE
Filing Requirement of Act 74, Mich. P.A. 1970

Re-Mon. Liber 2, Page 10

For Corners in

Huron
(County)

Located in:

Corner Code #

RECORDED

- 1. Public Land survey: Lake T 18_N_ R 11_E L-13
2. Property Controlling in Section S T R
3. Miscellaneous Property in Sec. S T R
4. Lot No. Recorded Plat
5. Private Claims

Dec 28 4 19 PM '99

Frances Holmbeck
REGISTER OF DEEDS
HURON COUNTY, MICHIGAN

Register of Deeds Stamp & File Number

I, James T. Meek, in a field survey on October 30, 1999, do hereby certify that under requirements of P.A. 74, Michigan P.A. of 1970, the corner points mentioned in lines 1 and 2 above were in conformance with regulations and rules thereof as required in the current manual of survey instructions of the United States Department of the Interior, Bureau of Land Management or by a decree of a Court of Law and/or that the corner points mentioned in lines 3, 4 and 5 above were in conformance with the rules of the Michigan Board of Land Surveyors or by a Decree of a Court of Law; established, re-established, monumented, re-monumented, recovered, found as expressed below:

Grid table with columns A-M and rows 2-13. Contains numbers 1-36 in a grid pattern.

NOTE: Not more than 2 corners, all in the same town and range, may be recorded on this certificate.

A. Description of original monument and accessories and/or subsequent restoration:

Original survey, South Bdy. T18N R11E, 1835, Harvey Parke D.S.

L-13 South 1/4 Corner of Section 36
Post
Sugar 9", N82°W, 26 1/2 links
Sugar 9", N38 1/2°E, 8 1/2 links

M-13 Corner of Townships 17 & 18 North, Ranges 11 & 12 East
Post
White Ash 8", N88°W, 9 links
Aspen 16", S88°E, 10 links

County Surveyor's Record: none
Recorded Surveys: none
LCRC: none

County Surveyor's Record: axle
Recorded Surveys: L3, P289
LCRC: none

B. Description of corner evidence found and/or method applied in restoring or reestablishing corner:

L-13 South 1/4 Corner of Section 36
Found PK nail at centerline of Kinde Road. Set 1/2" iron in mon box.
Accepted as the best available evidence of the original corner position.


M-13 Corner of Townships 17 & 18 North, Ranges 11 & 12 East
Found 1 1/4" pipe at intersection of Grassmere and Kinde Roads
Accepted as the best available evidence of the original corner position.

C. Description of monument for corner and accessories established to perpetuate locating the position of the corner:

L-13 South 1/4 Corner of Section 36
1/2" iron in mon box
From which:
Tag in power pole bears North, 54.0'
No Passing Zone sign post bears N80°E, 110.0'
Do Not Pass sign post bears S80°E, 108.5'
1/2" iron bears S45°W, 22.0'

M-13 Corner of Townships 17 & 18 North, Ranges 11 & 12 East
1 1/4" pipe in mon box
From which:
Tag in power pole bears N45°E, 85.4'
Stop sign post bears S20°E, 37.0'
Tag in fence post corner bears S40°W, 48.5'
Stop sign post bears N30°W, 37.7'

Signed by [Signature] Date 12-21-99
Surveyor's Michigan License No. 39089

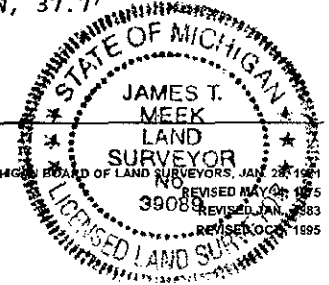

APPROVED AT PEER BOARD MEETING 12-16-99 RLB