

Common to:  
 A01 - Meade Twp. - T17N-R12E  
 M01 - Chandler Twp. - T17N-R11E  
 M13 - Lake Twp. - T18N-R11E

*Re - Mon. Refer 2, Page 13*

1999 REMONUMENTATION

LAND CORNER RECORDATION CERTIFICATE  
 Filing Requirement of Act 74, Mich. P.A. 1970

RECORDED

For Corners in	Located in:	Corner Code #
<u>Huron</u> (County)		
1. Public Land survey: <u>Hume</u>	T <u>18</u> N R <u>12</u> E	<u>A-13</u>
	T _____ R _____	_____
	T _____ R _____	_____
	T _____ R _____	_____
2. Property Controlling in Section	S _____ T _____ R _____	_____
	S _____ T _____ R _____	_____
3. Miscellaneous Property in Sec.	S _____ T _____ R _____	_____
	S _____ T _____ R _____	_____
4. Lot No. _____, Recorded Plat _____		
5. Private Claims _____		

Dec 28 4 19 PM '99

*Francesca Holton*  
 REGISTER OF DEEDS  
 HURON COUNTY, MICHIGAN

Register of Deeds Stamp & File Number

I, James T. Meek, in a field survey on October 30, 1999, do hereby certify that under requirements of P.A. 74, Michigan P.A. of 1970, the corner points mentioned in lines 1 and 2 above were in conformance with regulations and rules thereof as required in the current manual of survey instructions of the United States Department of the Interior, Bureau of Land Management or by a decree of a Court of Law and/or that the corner points mentioned in lines 3, 4 and 5 above were in conformance with the rules of the Michigan Board of Land Surveyors or by a Decree of a Court of Law; established, re-established, monumented, re-monumented, recovered, found as expressed below:

	A	B	C	D	E	F	G	H	I	J	K	L	M
2	6		5		4		3		2		1		
3													
4	7		8		9		10		11		12		
5													
6	18		17		16		15		14		13		
7													
8	19		20		21		22		23		24		
9													
10	30		29		28		27		26		25		
11													
12	31		32		33		34		35		36		
13													


NOTE: Not more than 2 corners, all in the same town and range, may be recorded on this certificate.

A. Description of original monument and accessories and/or subsequent restoration:  
 Original survey, South Bdy. T18NR12E, 1835, Harvey Parke D.S.  
 A-13 Corner of Townships 17 and 18 North, Ranges 11 and 12 East  
 Post  
 White Ash 8", N88°W, 9 links  
 Aspen 16", S88°E, 10 links  
 County Surveyor's Record: axle  
 Recorded Surveys: L3, P289  
 LCRC: none

REF  
 FEB 2006  
 SECTION

B. Description of corner evidence found and/or method applied in restoring or reestablishing corner:  
 A-13 Corner of Townships 17 and 18 North, Ranges 10 and 11 East  
 Found 1 1/4" pipe at intersection of Grassmere and Kinde Roads.  
 Accepted as the best available evidence of the original corner position.

C. Description of monument for corner and accessories established to perpetuate locating the position of the corner:  
 A-13 Corner of Townships 17 and 18 North, Ranges 10 and 11 East  
 1 1/4" pipe in mon box  
 From which:  
 Tag in power pole bears N45°E, 85.4'  
 Stop sign post bears S20°E, 37.0'  
 Tag in fence post corner bears S40°W, 48.5'  
 Stop sign post bears N30°W, 37.7'

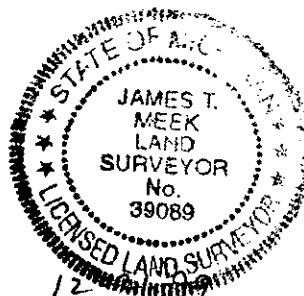

Signed by [Signature] Date 12  
 Surveyor's Michigan License No. 39089

APPROVED AT PEER BOARD MEETING 12-16-99 RLB