

Re-Mon. Liber 2, Page 14

For Corners in

Huron
(County) Located in: Corner Code #

1. Public Land survey: Hume Lake T 18_N R 13E B-13 ✓
 T ___ R ___
 T ___ R ___
 T ___ R ___
 T ___ R ___

2. Property Controlling S ___ T ___ R ___
 in Section S ___ T ___ R ___

3. Miscellaneous S ___ T ___ R ___
 Property in Sec. S ___ T ___ R ___

4. Lot No. _____, Recorded Plat _____

5. Private Claims _____

SECTION

Dec 28 4 19 PM '99

Frances Malanick
REGISTER OF DEEDS
HURON COUNTY, MICHIGAN

Register of Deeds Stamp & File Number

I, James T. Meek, in a field survey on October 30, 1999, do hereby certify that under requirements of P.A. 74, Michigan P.A. of 1970, the corner points mentioned in lines 1 and 2 above were in conformance with regulations and rules thereof as required in the current manual of survey instructions of the United States Department of the Interior, Bureau of Land Management or by a decree of a Court of Law and/or that the corner points mentioned in lines 3, 4 and 5 above were in conformance with the rules of the Michigan Board of Land Surveyors or by a Decree of a Court of Law, established, re-established, monumented, re-monumented, recovered, found as expressed below:

	A	B	C	D	E	F	G	H	I	J	K	L	M
2	6	5	4	3	2	1							
3													
4	7	8	9	10	11	12							
5													
6	18	17	16	15	14	13							
7													
8	19	20	21	22	23	24							
9													
10	30	29	28	27	26	25							
11													
12	31	32	33	34	35	36							
13													

NOTE: Not more than 2 corners, all in the same town and range, may be recorded on this certificate.

A. Description of original monument and accessories and/or subsequent restoration:
Original survey, South Bdy. T18NR11E, 1835, Harvey Parke D.S.

B-13 South ¼ Corner of Section 31
Post
Elm 26", N55½°W, 17 links
Lynn 12", N70°E, 19 links

County Surveyor's Record: none
Recorded Surveys: none
LCRC: none

B. Description of corner evidence found and/or method applied in restoring or reestablishing corner:

B-13 South ¼ Corner of Section 31

Found ¾" iron in mon box

Accepted as the best available evidence of the original corner position.


C. Description of monument for corner and accessories established to perpetuate locating the position of the corner:

B-13 South ¼ Corner of Section 31

¾" iron in mon box

From which:
Do Not Pass sign post bears N10°W, 19.5'
½" iron bears N45°E, 33.0'
No Passing Zone sign post bears S10°W, 19.4'
¼" iron bears S45°W, 26.0'

**Recessing to correct erroneous town and range. Gmit 12/21/99.*

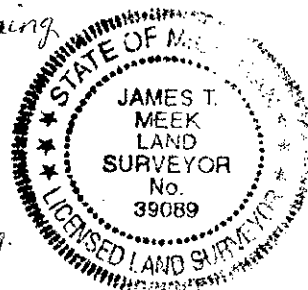

Signed by [Signature]

Date 12-21-99

Surveyor's Michigan License No. 39089