

Re-Mon. Liber 2, Page 16

RECORDED

For Corners in

<u>Huron</u> (County)	Located in:	Corner Code #
1. Public Land survey: <u>Hume</u>	T 18_N_ R 12_E	F-13
	T ___ R ___	G-13 ✓
	T ___ R ___	
	T ___ R ___	
2. Property Controlling in Section	S ___ T ___ R ___	
	S ___ T ___ R ___	
3. Miscellaneous Property in Sec.	S ___ T ___ R ___	
	S ___ T ___ R ___	
4. Lot No. _____, Recorded Plat _____		
5. Private Claims _____		

Dec 28 4 19 PM '99

Frances Hallock
REGISTER OF DEEDS
HURON COUNTY, MICHIGAN

Register of Deeds Stamp & File Number

I, James T. Meek, in a field survey on October 30, 1999, do hereby certify that under requirements of P.A. 74, Michigan P.A. of 1970, the corner points mentioned in lines 1 and 2 above were in conformance with regulations and rules thereof as required in the current manual of survey instructions of the United States Department of the Interior, Bureau of Land Management or by a decree of a Court of Law and/or that the corner points mentioned in lines 3, 4 and 5 above were in conformance with the rules of the Michigan Board of Land Surveyors or by a Decree of a Court of Law; established, re-established, monumented, re-monumented, recovered, found as expressed below:

A	B	C	D	E	F	G	H	I	J	K	L	M
2	6	5	4	3	2	1						
3												
4	7	6	5	4	3	2	1					
5												
6	18	17	16	15	14	13						
7												
8	19	20	21	22	23	24						
9												
10	30	29	28	27	26	25						
11												
12	31	32	33	34	35	36						
13												

NOTE: Not more than 2 corners, all in the same town and range, may be recorded on this certificate.

A. Description of original monument and accessories and/or subsequent restoration:

Original survey, South Bdy. T18NR12E, 1835, Harvey Parke D.S.

F-13 South 1/4 Corner of Section 33
Post
Hemlock 16", N88 1/4°E, 40 links
Lynn 12", N72°W, 33 links

G-13 Corner of Sections 33 and 34
Post
Beech 17", N25°E, 25 links
Beech 20", N61°W, 47 links

County Surveyor's Record: none
Recorded Surveys: none
LCRC: none

County Surveyor's Record: pointed boulder
Recorded Surveys: L3, P477
LCRC: none

B. Description of corner evidence found and/or method applied in restoring or reestablishing corner:

F-13 South 1/4 Corner of Section 33

G-13 Corner of Sections 33 and 34

Found 1" iron in mon box at centerline of Kinde Road

Found 1" iron in mon box at intersection of Kinde & McMillan Roads.

Accepted as the best available evidence of the original corner position.

Accepted as the best available evidence of the original corner position.

C. Description of monument for corner and accessories established to perpetuate locating the position of the corner:

F-13 South 1/4 Corner of Section 33

G-13 Corner of Sections 33 and 34


1" iron in mon box

1" iron in mon box

From which:
1" iron in mon box bears East, 112.78'
Tag in 16" cottonwood bears N10°E, 48.1'
1/2" iron bears South, 15.0'
Tag in twin maple bears N20°W, 57.25'
1/2" iron bears S45°W, 29.0'

From which:
1" iron in mon box bears East, 102.64'
East direct. sign post bears South, 20.8'
Low shoulder sign post bears N20°E, 70.8'
Road sign post bears N20°W, 39.3'

Signed by *James T. Meek* Date 12-16-99
Surveyor's Michigan License No. 39089

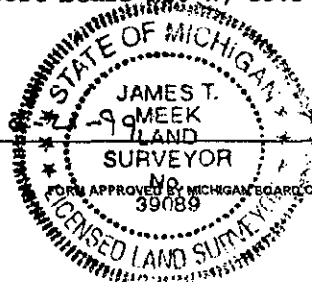

APPROVED AT PEER BOARD MEETING 12-16-99 RLB