

1999 REMONUMENTATION

LAND CORNER RECORDATION CERTIFICATE
Filing Requirement of Act 74, Mich. P.A. 1970

RECORDED

For Corners in Huron (County) Located in: Corner Code #

1. Public Land survey: Hume T 18_N_ R 12_E J-13
 T ___ R ___ K-13 ✓
 T ___ R ___
 T ___ R ___

2. Property Controlling in Section S ___ T ___ R ___
 S ___ T ___ R ___

3. Miscellaneous Property in Sec. S ___ T ___ R ___
 S ___ T ___ R ___

4. Lot No. _____, Recorded Plat _____

5. Private Claims _____ SECTION _____

DEC 28 4 19 PM '99

Frances Hallock
 REGISTER OF DEEDS
 HURON COUNTY, MICHIGAN

Register of Deeds Stamp & File Number

I, James T. Meek, in a field survey on October 30, 1999, do hereby certify that under requirements of P.A. 74, Michigan P.A. of 1970, the corner points mentioned in lines 1 and 2 above were in conformance with regulations and rules thereof as required in the current manual of survey instructions of the United States Department of the Interior, Bureau of Land Management or by a decree of a Court of Law and/or that the corner points mentioned in lines 3, 4 and 5 above were in conformance with the rules of the Michigan Board of Land Surveyors or by a Decree of a Court of Law; established, re-established, monumented, re-monumented, recovered, found as expressed below:

	A	B	C	D	E	F	G	H	I	J	K	L	M
2	6	5	4	3	2	1							
3													
4	7	8	9	10	11	12							
5													
6	18	17	16	15	14	13							
7													
8	19	20	21	22	23	24							
9													
10	30	29	28	27	26	25							
11													
12	31	32	33	34	35	36							
13													

NOTE: Not more than 2 corners, all in the same town and range, may be recorded on this certificate.

A. Description of original monument and accessories and/or subsequent restoration:

Original survey, South Bdy. T18NR12E, 1835, Harvey Parke D.S.
 J-13 South ¼ Corner of Section 35
 Post
 Hemlock 14", N30°E, 9 links
 Hemlock 6", N77°W, 3 links

County Surveyor's Record: iron pin
 Recorded Surveys: none
 LCRC: none

K-13 Corner of Sections 35 and 36
 Post
 Hemlock 26", N50°E, 35 links
 Hemlock 9", N72½°W, 32 links

County Surveyor's Record: none
 Recorded Surveys: none
 LCRC: none

B. Description of corner evidence found and/or method applied in restoring or reestablishing corner:

J-13 South ¼ Corner of Section 35
 Found 1" pipe in mon box at intersection of Kinde & Shinevale Roads.
 Accepted as the best available evidence of the original corner position.

K-13 Corner of Sections 35 and 36
 Found no evidence of the original corner position. Set ½" iron w/cap #39089 in mon box at record offset from the corner of Sections 1 & 2, T17N-R12E.

C. Description of monument for corner and accessories established to perpetuate locating the position of the corner:


J-13 South ¼ Corner of Section 35
 1" pipe in mon box

From which:
 ½" iron in mon box bears East 41.60'
 Tag in power pole bears N30°E, 98.8'
 West direct. sign post bears South, 20.6'
 Tag in power pole bears S30°W, 54.2'
 Road sign post bears N15°W, 41.8'

K-13 Corner of Sections 35 and 36
 ½" iron w/cap #39089

From which:
 1" iron in mon box bears East, 70.62'
 PK nail in power pole bears N40°E, 57.1'
 Tag in power pole bears S40°E, 56.2'
 ½" iron bears S45°W, 25.0'
 Tag in 14" cottonwood bears N40°E, 35'

Signed by [Signature] Date 12-21-99
 Surveyor's Michigan License No. 39089

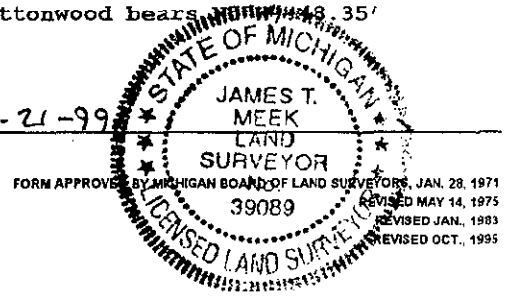

APPROVED AT PEER BOARD MEETING 12-16-99 RRB