

Common to:  
 A13 - Dwight Twp. - T18N-R13E  
 A01 - Lincoln Twp. - T17N-R13E  
 M01 - Meade Twp. - T17N-R12E

*Re - Mon. Ledger 2, Page 18*

1999 REMONUMENTATION

LAND CORNER RECORDATION CERTIFICATE  
 Filing Requirement of Act 74, Mich. P.A. 1970

RECORDED

For Corners in  
Huron  
 (County)

Located in: Corner Code #

1. Public Land survey: Hume T 18\_N\_ R 12\_E L-13  
 T \_\_\_\_\_ R \_\_\_\_\_ M-13 ✓  
 T \_\_\_\_\_ R \_\_\_\_\_  
 T \_\_\_\_\_ R \_\_\_\_\_

2. Property Controlling S \_\_\_\_\_ T \_\_\_\_\_ R \_\_\_\_\_  
 in Section S \_\_\_\_\_ T \_\_\_\_\_ R \_\_\_\_\_

3. Miscellaneous S \_\_\_\_\_ T \_\_\_\_\_ R \_\_\_\_\_  
 Property in Sec. S \_\_\_\_\_ T \_\_\_\_\_ R \_\_\_\_\_

4. Lot No. \_\_\_\_\_, Recorded Plat \_\_\_\_\_

5. Private Claims \_\_\_\_\_

DEC 28 4 19 PM '99  
*Francesa Holmquist*  
 REGISTER OF DEEDS  
 HURON COUNTY, MICHIGAN

Register of Deeds Stamp & File Number

FEB 02 2000

SECTION

I, James T. Meek, in a field survey on October 30, 1999, do hereby certify that under requirements of P.A. 74, Michigan P.A. of 1970, the corner points mentioned in lines 1 and 2 above were in conformance with regulations and rules thereof as required in the current manual of survey instructions of the United States Department of the Interior, Bureau of Land Management or by a decree of a Court of Law and/or that the corner points mentioned in lines 3, 4 and 5 above were in conformance with the rules of the Michigan Board of Land Surveyors or by a Decree of a Court of Law; established, re-established, monumented, re-monumented, recovered, found as expressed below:

	A	B	C	D	E	F	G	H	I	J	K	L	M
2	6			5		4		3		2		1	
3													
4	7			8		9		10		11		12	
5													
6	18			17		16		15		14		13	
7													
8	19			20		21		22		23		24	
9													
10	30			29		28		27		26		25	
11													
12	31			32		33		34		35		36	
13													

NOTE: Not more than 2 corners, all in the same town and range, may be recorded on this certificate.

A. Description of original monument and accessories and/or subsequent restoration:

Original survey, South Bdy. T18NR12E, 1835, Harvey Parke D.S.

L-13 South ¼ Corner of Section 36  
 Post  
 Fir 11", N47°E, 7 links  
 Fir 7", N28°W, 19 links

County Surveyor's Record: iron pin  
 Recorded Surveys: L1, P539; L3, P717  
 LCRC: none

M-13 Corner of Townships 17 & 18 North, Ranges 12 & 13 East  
 Post  
 Pine 20", S85½°W, 22½ links  
 Elm 10", N78°E, 2 links  
 County Surveyor's Record: iron in mon box  
 Recorded Surveys: L1, P339; L1, P377; L3, P717; L1, P46; L2, P250  
 LCRC: none

B. Description of corner evidence found and/or method applied in restoring or reestablishing corner:

L-13 South ¼ Corner of Section 36  
 Found 2" pipe in mon box at centerline of Kinde Road. Occupation line bears North.  
 Accepted as the best available evidence of the original corner position.


M-13 Corner of Townships 17 & 18 North, Ranges 12 & 13 East  
 Found ½" iron w/cap in mon box. At intersection of Kinde Road & Michigan Highway M-53 (Van Dyke Road).  
 Accepted as the best available evidence of the original corner position.

C. Description of monument for corner and accessories established to perpetuate locating the position of the corner:

L-13 South ¼ Corner of Section 36  
 2" pipe in mon box  
 From which:  
 Tag in 12" walnut bears North, 71.6'  
 Tag in power pole bears N60°E, 111.6'  
 Tag in fence post bears S40°E, 52.5'  
 ½" iron bears South, 16.0'

M-13 Corner of Townships 17 & 18 North, Ranges 12 & 13 East  
 ½" iron w/cap in mon box  
 From which:  
 Tag in power pole bears N40°E, 64.0'  
 School sign post bears S60°E, 99.4'  
 Tag in power pole bears S45°W, 68.25'  
 Road sign post bears N45°W, 51.5'

Signed by *James T. Meek* Date 12-21-99  
 Surveyor's Michigan License No. 39089

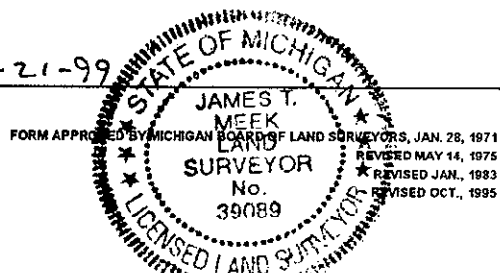

APPROVED AT PEER BOARD MEETING 12-16-99 RLB