

Re Mon Feder 2, Page 8

1999 REMONUMENTATION

LAND CORNER RECORDATION CERTIFICATE
Filing Requirement of Act 74, Mich. P.A. 1970

For Corners in <u>Huron</u> (County)	Located in:	Corner Code #
1. Public Land survey: <u>Hume</u>	T 18_N_ R 12_E	<u>B-13</u> ✓
	T _____ R _____	<u>C-13</u>
	T _____ R _____	
	T _____ R _____	
2. Property Controlling in Section	S _____ T _____ R _____	
3. Miscellaneous Property in Sec.	S _____ T _____ R _____	
4. Lot No. _____, Recorded Plat _____		
5. Private Claims _____		

Seg #2

STATE OF MICHIGAN
HURON COUNTY
RECORDED

29 NOV 2000 11:20 AM

FRANCES L. HOLDWICK
REGISTER OF DEEDS

Register of Deeds Stamp & File Number

A	B	C	D	E	F	G	H	I	J	K	L
2	6	5	4	3	2	1					
3											
4	7	8	9	10	11	12					
5											
6	18	17	16	15	14	13					
7											
8	19	20	21	22	23	24					
9											
10	30	29	28	27	26	25					
11											
12	31	32	33	34	35	36					
13											

I, James T. Meek, in a field survey on October 30, 1999, do hereby certify that under requirements of P.A. 74, Michigan P.A. of 1970, the corner points mentioned in lines 1 and 2 above were in conformance with regulations and rules thereof as required in the current manual of survey instructions of the United States Department of the Interior, Bureau of Land Management or by a decree of a Court of Law and/or that the corner points mentioned in lines 3, 4 and 5 above were in conformance with the rules of the Michigan Board of Land Surveyors or by a Decree of a Court of Law; established, re-established, monumented, re-monumented, recovered, found as expressed below:

NOTE: Not more than 2 corners, all in the same town and range, may be recorded on this certificate.

A. Description of original monument and accessories and/or subsequent restoration:

Original survey, South Bdy. T18NR12E, 1835, Harvey Parke D.S.

B-13 South ¼ Corner of Section 31
Post
Hemlock 11", N88°E, 11 links
Hemlock 28", N42°W, 22 links

County Surveyor's Record: none
Recorded Surveys: none
LCRC: none

C-13 Corner of Sections 31 and 32
Post
Sugar 30", N67½°E, 30 links
Beech 12", N61½°W, 10½ links

County Surveyor's Record: 1" gas pipe
Recorded Surveys: L3, P197
LCRC: none

B. Description of corner evidence found and/or method applied in restoring or reestablishing corner:

B-13 South ¼ Corner of Section 31
Found 1" iron at centerline of Kinde Road. Occupation line bears north

Accepted as the best available evidence of the original corner position.

C-13 Corner of Sections 31 and 32
Found ¾" iron at intersection of Pinnebog & Kinde Roads

Accepted as the best available evidence of the original corner position.

C. Description of monument for corner and accessories established to perpetuate locating the position of the corner:


B-13 South ¼ Corner of Section 31
1" iron in mon box
From which:
Tag in power pole bears North, 53.8'
½" iron bears N45°E, 26.0'
½" iron bears S45°E, 25.0'
½" iron bears S45°W, 24.0'

C-13 Corner of Sections 31 and 32
¾" iron in mon box
From which:
Tag in power pole bears N50°E, 66.5'
NW cor building bears S20°E, 59.0'
Tag in power pole bears S60°W, 67.3'
Stop sign post bears N25°W, 46.2'
1" iron in mon box bears East, 225.65'

Signed by [Signature]
Surveyor's Michigan License No. 39089

Date 2000

APPROVED AT PEER BOARD MEETING 11-02-00 RLB

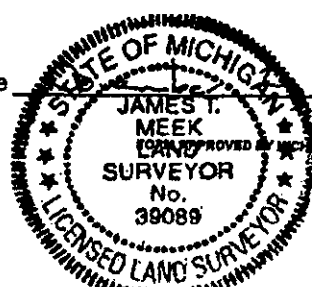

REVISOR'S BOARD OF LAND SURVEYORS, JAN. 28, 1971
REVISED MAY 14, 1972
REVISED JAN., 1981
REVISED OCT., 1991