

Common to:
 M01 - Hume Twp. - T18N-R12E
 M13 - Port Austin Twp. - T19N-R12E
 A13 - Port Austin Twp. - T19N-R13E

Re-Man. Liber 2, Page 21

**1999 REMONUMENTATION
 LAND CORNER RECORDATION CERTIFICATE
 Filing Requirement of Act 74, Mich. P.A. 1970**


For Corners in DWIGHT Township

<u>Huron</u> (County)	Located in:	Corner Code #
1. Public Land Survey	T 18N R 13E	A - 1
	T-----R-----	
	T-----R-----	
	T-----R-----	
2. Property Controlling S in Section S	T-----R-----	
3. Miscellaneous S Property in Sec. S	T-----R-----	
	T-----R-----	

STATE OF MICHIGAN
 HURON COUNTY
 RECORDED
 30 DEC 99 2:12 P.M.
 FRANCES L. HOLDWICK
 REGISTER OF DEEDS
 Register of Deeds Stamp & File Number

4. Lot No. _____, Recorded Plat _____
 5. Private Claims _____

FEB 1 2000
 SECTION

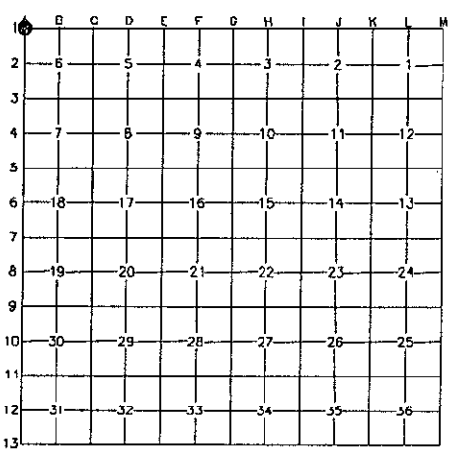


I, Russell L. Brown, in a field survey on Dec. 10, 1999 do hereby state that under requirements of P.A. 74, Michigan P.A. of 1970, the corner points mentioned in lines 1 and 2 above were in conformance with regulations and rules therefore as required in the current manual of survey instructions of the United States Department of the Interior, Bureau of Land Management or by a decree of a Court of Law and/or that the corner points mentioned in lines 3, 4, and 5 above were in conformance with the rules of the Michigan Board of Land Surveyors or by a Decree of a Court of Law; established, re-established, monumented, recovered, found as expressed below:

NOTE: Not more than 2 corners, all in the same town and range, may be recorded on this certificate.

A. Description of original monument and accessories and/or subsequent restoration:
 1834 G.L.O. H. Parke D.S. Set Post Corner Tp. 18 and 17N Rs 12 and 13 East, Sugar 16 S1E 15 1/2, Hemlock 18 N50 1/2W 22
 County Surveyors Records - None
 County Road Commission Records Cedar Post 10.6' due East of this point; Fence Post due South 45.40'
 Corner Fence Post N45°W 38.50'; Corner Fence Post N60°E 66.75'
 L.C.R.C. - None
 Recorded Surveys Sept. 29, 1972 Stewart G. Case P.S. 15399; Found remains of Cedar Post, placed 1" Pipe in Cedar Post and raised with 1/2" Steel Pin WITNESSES Spike S.E. Side of Corner Post N43°E 46.0'; Spike E. Side of power pole S25°E 37.0'; 1/2" Steel Pin N40°W 47.0'
 Unrecorded Surveys - None

B. Description of corner evidence found and/or method applied in restoring or reestablishing corner:
 No evidence of original corner or accessories found.
 Found 1/2" Steel Stake in 1" Pipe and pieces of wood post
 Accepted Found 1/2" Steel Stake in 1" Pipe as best evidence of original corner position.

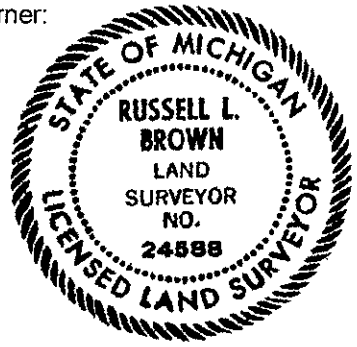

C. Description of monument for corner and accessories established to perpetuate locating the position of the corner:
 A-1, Northwest Corner Section 6, T18N-R13E
 Found 1/2" Steel Stake in 1" Pipe Centerline Knoblock and Larned Roads
 WITNESSES
 N35°W 59.16' to Spike in Southwesterly face of Power Pole
 S15°W 36.94' to Spike in East face of Power pole
 S70°W 111.90' to P.K. Nail in North face Power Pole
 S45°W 44.97' to Concrete Nail in West end 12" Plastic Drive Culvert
 East 2739.92' to B-13, South 1/4 Corner Section 31, T19N-R13E
 West 2635.83' to L-13, South 1/4 Corner Section 36, T19N-R12E

NOTE:
 This corner common with
 A-13, T19N-R13E
 M-13, T19N-R12E
 M-1, T18N-R12E

Signed by *Russell L. Brown* Date *Dec 27, 1999*
 Surveyor's Michigan License No. 24588

Peer group approved at meeting held *12-27-99*, *RLB*