

Re-Mon Liber 1, Page 235

1999 REMONUMENTATION

LAND CORNER RECORDATION CERTIFICATE
Filing Requirement of Act 74, Mich. P.A. 1970

For corners in

<u>Huron</u> (County)	Located in:	Corner Code #
1. Public Land Survey	Dwight T18NR13E	B-13
	T R	
	T R	
	T R	
2. Property Controlling in Section	S T R	
	S T R	
3. Miscellaneous Property in Sec.	S T R	
	S T R	

STATE OF MICHIGAN
HURON COUNTY
RECORDED

28 OCT 99 9:11 A.M.

FRANCES L. HOLMICK
REGISTER OF DEEDS

Register of Deeds Stamp & File Number

4. Lot No. _____, Recorded Plat _____
5. Private Claims _____

I, Charles S. Getz, in a field survey on April 12, 1999 do hereby state that under requirements of P.A. 74, Michigan P.A. of 1970, the corner points mentioned in lines 1 and 2 above were in conformance with regulations and rules therefore as required in the current manual of survey instructions of the United States Department of the Interior, Bureau of Land Management or by a decree of a Court of Law and /or that the corner points mentioned in lines 3, 4 and 5 above were in conformance with the rules of the Michigan Board of Land Surveyors or by a Decree of a Court of Law; established, re-established, monumented, recovered, found as expressed below:

NOTE: Not more than 2 corners, all in the same town and range, may be recorded on this certificate.

	A	B	C	D	E	F	G	H	I	J	K	L
1												
2	6		5		4		3		2		1	
3												
4	7		8		9		10		11		12	
5												
6	18		17		16		15		14		13	
7												
8	19		20		21		22		23		24	
9												
10	30		29		28		27		26		25	
11												
12	31		32		33		34		35		36	
13												

A. Description of original monument and accessories and/or subsequent restoration:

B-13 1834 G.L.O., H. Parke D.S. County Road Commission Records - NONE

Set quarter section post
Hemlock 9", N62°E, 17 Links
Beech 12", N71°E, 37 Links

Recorded Surveys -
Case, 8-23-78, Liber 3, Page 537, 1/4 of Conc. road on Section line
Case, 8-23-78, Liber 3, Page 541, Section Cor. location taken
Case, 12-2-92, Liber 5, Page 92, from village plats.

L.C.R.C. - NONE

Unrecorded Surveys -
Case, 1992, 1/4 of conc. road on Section Line. Section corner location taken from village plats.
Brown, 5-20-92, P.K. Nail
Milletics, 6-17-93, Certificate shows Corner

County Surveyor Records - NONE

B. Description of corner evidence found and/or method applied in restoring or reestablishing corner:

B-13
S 1/4 Cor, Section 31, T18N-R13E
Found P.K. Nail as per Survey by Huron Surveying, Inc. dated 5-20-92
Accepted as the best available evidence of original corner position
(On Kinde Road)


REMONUMENTATION

FEB 22 2000

SECTION

C. Description of monument for corner and accessories established to perpetuate locating the position of the corner:

B-13
S 1/4 Cor, Section 31, T18N-R13E
Set 1/2" Iron Bar in Monument Box (Capped)
West 89.27' to P.K. Nail
West 42.51' to P.K. Nail
N50°W 60.80' to Southeast Corner of Catch Basin
S50°W 63.30' to Northwest Corner of Catch Basin
N05°W 37.45' to Nail in Light Pole
S05°W 23.75' to Northeast Corner of Catch Basin
West 2652.26' to SW Cor, Sec 31, T18N-R13E
East 2628.15' to SE Cor, Sec 31, T18N-R13E

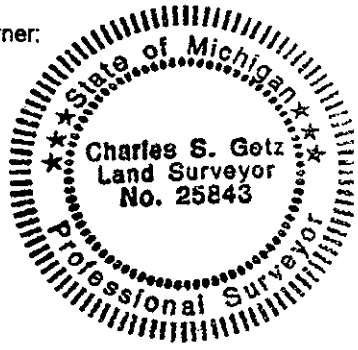

Signed by Charles S. Getz
Surveyor's Michigan License No. 25843

Date August 14, 1999

PEER GROUP APPROVED AT MEETING
HELD October 26, 1999. RAB