

Re Mon Liked, Page 242

1999 REMONUMENTATION

STATE OF MICHIGAN
HURON COUNTY
RECORDED

LAND CORNER RECORDATION CERTIFICATE
Filing Requirement of Act 74, Mich. P.A. 1970

28 OCT 99 9:12 A.M.

FRANCES L. HOLDWICK
REGISTER OF DEEDS

For corners in

Huron (County)	Located In:	Corner Code #
1. Public Land Survey	Dwight T18N R13E	I-13
	T R	
	T R	
	T R	
2. Property Controlling in Section	S T R	
	S T R	
3. Miscellaneous Property in Sec.	S T R	
	S T R	

Register of Deeds Stamp & File Number

4. Lot No. _____, Recorded Plat _____
5. Private Claims _____

I, Charles S. Getz, in a field survey on April 12, 1999 do hereby state that under requirements of P.A. 74, Michigan P.A. of 1970, the corner points mentioned in lines 1 and 2 above were in conformance with regulations and rules therefore as required in the current manual of survey instructions of the United States Department of the Interior, Bureau of Land Management or by a decree of a Court of Law and/or that the corner points mentioned in lines 3, 4 and 5 above were in conformance with the rules of the Michigan Board of Land Surveyors or by a Decree of a Court of Law, established, re-established, monumented, recovered, found as expressed below:

NOTE: Not more than 2 corners, all in the same town and range, may be recorded on this certificate.

	A	B	C	D	E	F	G	H	I	J	K	L	M
1													
2	6		5		4		3		2		1		
3													
4	7		8		9		10		11		12		
5													
6	18		17		16		15		14		13		
7													
8	19		20		21		22		23		24		
9													
10	30		29		28		27		26		25		
11													
12	31		32		33		34		35		36		
13													

A. Description of original monument and accessories and/or subsequent restoration:

I-13 1834 G.L.O., H. Parke D.S. County Road Commission Reords - 3/4" Iron Pin in Wood Post
Set Post Recorded Surveys - NONE
Hemlock 10", N87°E, 10 Links
Do. 10", N68 1/2°W, 28 Links Unrecorded Surveys -
Case, 12-6-88, 3/4" st. pipe in Mon. Box.

L.C.R.C. - NONE

County Surveyor Record -
NONE


B. Description of corner evidence found and/or method applied in restoring or reestablishing corner:

I-13
SW Cor, Section 35, T18N-R13E
Found 5/8" Iron Bar in Monument Box
Accepted as the best available evidence
of original corner position
(Intersection of Kinde & Sullivan Roads)

RECORDED
FEB 03 2000
SECTION

C. Description of monument for corner and accessories established to perpetuate locating the position of the corner:

I-13
SW Cor, Section 35, T18N-R13E
Found 5/8" Iron Bar in Monument Box
West 123.10' to Monument Box
South 19.45' to East Leg of Road Sign
S30°E 45.62' to Nail in Anchor Pole
N25°W 35.85' to Stop Sign
N30°E 47.77' to Nail in Power Pole
West 2636.68' to S 1/4 Cor, Sec 34, T18N-R13E
East 2632.10' to S 1/4 Cor, Sec 35, T18N-R13E

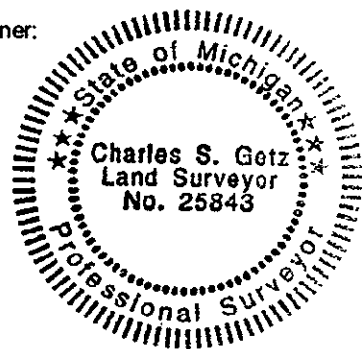

Signed by Charles S. Getz
Surveyor's Michigan License No. 25843

Date August 14, 1999

PEER GROUP APPROVED AT MEETING
HELD October 26, 1999 R.S.B.