

Re-Monumentation, Page 243

1999 REMONUMENTATION

LAND CORNER RECORDATION CERTIFICATE
Filing Requirement of Act 74, Mich. P.A. 1970

For corners in

Huron
(County)

Located In:

Corner Code #

1. Public Land Survey	Dwight	T18N R13E	J-13
		T___ R___	_____
		T___ R___	_____
		T___ R___	_____
2. Property Controlling in Section	S___	T___ R___	_____
	S___	T___ R___	_____
3. Miscellaneous Property in Sec.	S___	T___ R___	_____
	S___	T___ R___	_____

STATE OF MICHIGAN
HURON COUNTY
RECORDED
28 OCT 99 9:12 A.M.
FRANCES L. HOLDWICK
REGISTER OF DEEDS
Register of Deeds Stamp & File Number

4. Lot No. _____, Recorded Plat _____
5. Private Claims _____

I, Charles S. Getz, in a field survey on April 12, 1999 do hereby state that under requirements of P.A. 74, Michigan P.A. of 1970, the corner points mentioned in lines 1 and 2 above were in conformance with regulations and rules therefore as required in the current manual of survey instructions of the United States Department of the Interior, Bureau of Land Management or by a decree of a Court of Law and /or that the corner points mentioned in lines 3, 4 and 5 above were in conformance with the rules of the Michigan Board of Land Surveyors or by a Decree of a Court of Law, established, re-established, monumented, recovered, found as expressed below:

NOTE: Not more than 2 corners, all in the same town and range, may be recorded on this certificate.

1	A	B	C	D	E	F	G	H	I	J	K	L	M
2		6		5		4		3		2		1	
3													
4		7		8		9		10		11		12	
5													
6		18		17		16		15		14		13	
7													
8		19		20		21		22		23		24	
9													
10		30		29		28		27		26		25	
11													
12		31		32		33		34		35		36	
13													

A. Description of original monument and accessories and/or subsequent restoration:

J-13 1834 G.L.O., H. Parke D.S. County Road Commission Records - 3/4" Iron Pin in Wood Post
Set quarter section post Recorded Surveys - NONE
Pine 16", N82°W, 14 1/2 Links Unrecorded Surveys -
Cedar 10", N88°E, 11 1/2 Links Case, May 1971, Certificate shows Corner
L.C.R.C. - NONE

County Surveyor Records - NONE


B. Description of corner evidence found and/or method applied in restoring or reestablishing corner:

J-13
S 1/4 Cor, Section 35, T18N-R13E
Found 3/4" Iron Bar in Monument Box
Accepted as the best available evidence of original corner position
(On Kinde Road)

RECORDED
FEB 2 1999
SECTION

C. Description of monument for corner and accessories established to perpetuate locating the position of the corner:

J-13
S 1/4 Cor, Section 35, T18N-R13E
Found 3/4" Iron Bar in Monument Box
West 85.14' to Monument Box
South 28.20' to East End of Culvert
S45°W 40.00' to West End of Culvert
N50°E 59.65' to Nail in Power Pole
N05°E 33.00' to Metal Culvert
S70°W 91.00' to Nail in Fence Post
West 2632.10' to SW Cor, Sec 35, T18N-R13E
East 2631.00' to SE Cor, Sec 35, T18N-R13E

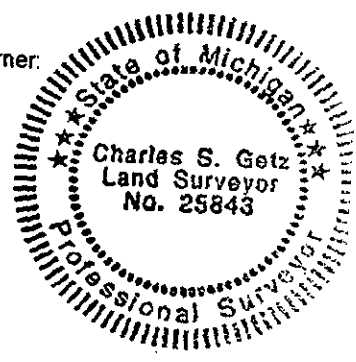

Signed by Charles S. Getz
Surveyor's Michigan License No. 25843

Date August 14, 1999

PEER GROUP APPROVED AT MEETING
HELD October 26, 1999 R.H.B.