

Re Mon Liber 1, Page 244

1999 REMONUMENTATION
LAND CORNER RECORDATION CERTIFICATE
Filing Requirement of Act 74, Mich. P.A. 1970

STATE OF MICHIGAN
HURON COUNTY
RECORDED

28 OCT 99 9:12 A.M.

FRANCES L. HOLLOWICK
REGISTER OF DEEDS

For corners in
Huron
(County)

Located In: Dwight Corner Code # K-13

1. Public Land Survey T18N R13E
T R
T R
T R
T R

2. Property Controlling
in Section S T R
S T R
S T R

3. Miscellaneous
Property in Sec. S T R

4. Lot No. _____, Recorded Plat _____
5. Private Claims _____

Register of Deeds Stamp & File Number

	A	B	C	D	E	F	G	H	I	J	K	L	M		
1															
2	6			5			4			3			2	1	
3															
4	7						8			9			10	11	12
5															
6	18						17			16			15	14	13
7															
8	19						20			21			22	23	24
9															
10	30						29			28			27	26	25
11															
12	31						32			33			34	35	36
13															

I, Charles S. Getz, in a field survey on April 12, 1999 do hereby state that under requirements of P.A. 74, Michigan P.A. of 1970, the corner points mentioned in lines 1 and 2 above were in conformance with regulations and rules therefore as required in the current manual of survey instructions of the United States Department of the Interior, Bureau of Land Management or by a decree of a Court of Law and/or that the corner points mentioned in lines 3, 4 and 5 above were in conformance with the rules of the Michigan Board of Land Surveyors or by a Decree of a Court of Law; established, re-established, monumented, recovered, found as expressed below:


NOTE: Not more than 2 corners, all in the same town and range, may be recorded on this certificate.

A. Description of original monument and accessories and/or subsequent restoration:
 K-13 1834 G.L.O., H. Parke D.S. County Road Commission Records - 3/4" Iron Pin in Wood Post
 Set Post Recorded Surveys -
 Sugar 8", N77 1/2° E, 25 Links Case, 3-24-72, Liber 1, Page 172, 3/4" Iron in place
 Hemlock 18", N76 1/2° W, 25 Links Case, 8-23-78, Liber 3, Page 470, 3/4" iron pin in place.
 L.C.R.C. - NONE Unrecorded Surveys -
 Case, May 1971, Certificate shows Corner

County Surveyor Records -
NONE

B. Description of corner evidence found and/or method applied in restoring or reestablishing corner:
 K-13
 SW Cor, Section 36, T18N-R13E
 Found 3/4" Iron Bar in Monument Box
 Accepted as the best available evidence
 of original corner position
 (Intersection of Kinde & Tomlinson Roads)

C. Description of monument for corner and accessories established to perpetuate locating the position of the corner:
 K-13
 SW Cor, Section 36, T18N-R13E
 Found 3/4" Iron Bar in Monument Box
 West 46.65' to Monument Box
 S60°E 75.15' to Nail in Telephone Pole
 S05°E 22.60' to West Leg of Road Sign
 S30°W 42.50' to Stop Sign
 N30°W 46.85' to Nail in Power Pole
 S40°W 55.00' to Nail in Anchor Pole
 West 2631.00' to S 1/4 Cor, Sec 35, T18N-R13E
 East 2628.58' to S 1/4 Cor, Sec 36, T18N-R13E

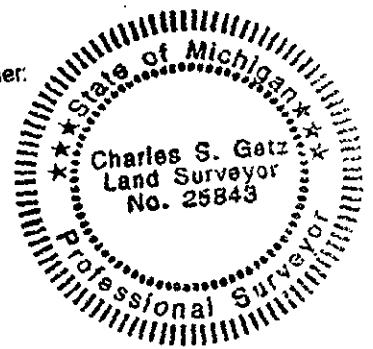

Signed by Charles S. Getz
 Surveyor's Michigan License No. 25843

Date August 14, 1999

PEER GROUP APPROVED AT MEETING
 HELD October 26, 1999 R.S.B.