

Common to:  
 M13 - Port Austin Twp. - T19N-R13E  
 A13 - Port Austin Twp. - T19N-R14E  
 A01 - Huron Twp. - T18N-R14E

*Re-Mon. Liber 2, Page 20*

**1999 REMONUMENTATION  
 LAND CORNER RECORDATION CERTIFICATE  
 Filing Requirement of Act 74, Mich. P.A. 1970**

For Corners in DWIGHT Township

<u>Huron</u> (County)	Located in:	Corner Code #
1. Public Land Survey	T 18N R 13E	M - 1
	T ----- R -----	
	T ----- R -----	
	T ----- R -----	
2. Property Controlling S in Section S	T ----- R -----	
	T ----- R -----	
3. Miscellaneous S Property in Sec. S	T ----- R -----	
	T ----- R -----	

STATE OF MICHIGAN  
 HURON COUNTY  
 RECORDED  
 30 DEC 99 2:12 P.M.  
 FRANCES L. HOLDWICK  
 REGISTER OF DEEDS  
 Register of Deeds Stamp & File Number

- 4. Lot No. \_\_\_\_\_, Recorded Plat \_\_\_\_\_
- 5. Private Claims \_\_\_\_\_

FEB 2 2000  
 SECTION


A	B	C	D	E	F	G	H	I	J	K	L	M
2	6	5	4	3	2	1						
3												
4	7	8	9	10	11	12						
5												
6	13	17	16	15	14	13						
7												
8	19	20	21	22	23	24						
9												
10	25	29	28	27	26	25						
11												
12	31	32	33	34	35	36						
13												

I, Russell L. Brown, in a field survey on Nov. 1, 1999 do hereby state that under requirements of P.A. 74, Michigan P.A. of 1970, the corner points mentioned in lines 1 and 2 above were in conformance with regulations and rules therefore as required in the current manual of survey instructions of the United States Department of the Interior, Bureau of Land Management or by a decree of a Court of Law and/or that the corner points mentioned in lines 3, 4, and 5 above were in conformance with the rules of the Michigan Board of Land Surveyors or by a Decree of a Court of Law; established, re-established, monumented, recovered, found as expressed below:

NOTE: Not more than 2 corners, all in the same town and range, may be recorded on this certificate.

A. Description of original monument and accessories and/or subsequent restoration:  
 1834 G.L.O. H. Parke D.S. Post Corners T18 and 19N, R13 and 14E, Sugar 10 N28W 6, Do. 8 S4E 12  
 County Surveyors Records - None  
 County Road Commission Records Dwight Twp. T18N-R13E, 1 NE, Iron Pin App. WITNESSES: P.K. P.P. S45W  
 56.05', Spike P.P. N45W 51.6'; Spike P.P. N55E 65.9'  
 L.C.R.C. - None  
 Recorded Surveys: Liber 1, Page 41, Stewart G. Case, P.S. 15399, Found 1" Steel Pin Center of intersection  
 WITNESSES: Face P.P. N60°E 65.6'; Face P.P. N50°W 51.0'; Face P.P. S50W 55.5'  
 Unrecorded Surveys - None

B. Description of corner evidence found and/or method applied in restoring or reestablishing corner:  
 No evidence of original corner of accessories found.  
 Found 3/4" Iron in Monument box  
 Accepted 3/4" Iron Found as best evidence of original corner position.

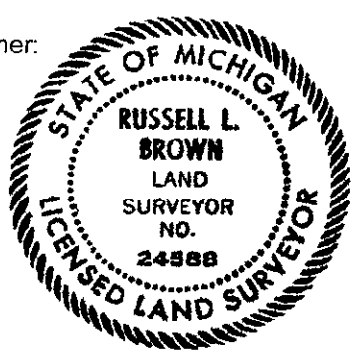

C. Description of monument for corner and accessories established to perpetuate locating the position of the corner:  
 M-1 N. E. Corner Section 1, T18N-R13E  
 3/4" Iron in Monument Box  
 WITNESSES:  
 N45°W 51.84' to Spike in N.E. Side of Power Pole  
 N50°E 65.90' to Spike in S.E. Side of Power Pole  
 S45°W 56.11' to Spike in S.E. Side of Power Pole  
 S45°E 49.69' to Notch in S. End C.M.P.  
 East 2645.23' to B-13, South 1/4 Corner, Section 31, T19N-R14E  
 West 2645.23' to L-13, South 1/4 Corner, Section 36, T19N-R13E

NOTE:  
 This Corner common with  
 A-1, T18N-R14E  
 A - 13, T19N-R14E  
 M - 13, T19N-R13E

Signed by Russell L. Brown  
 Surveyor's Michigan License No. 24588

Date Dec. 27, 1999

Peer group approved at meeting held 12-27-99, RLB