

Common to:  
 A01 - Bloomfield Twp. - T17N-R14E  
 M01 - Lincoln Twp. - T17N-R13E  
 M13 - Dwight Twp. - T18N-R13E

*Re Mon Liber 1, Page 247*

1999 REMONUMENTATION

LAND CORNER RECORDATION CERTIFICATE  
 Filing Requirement of Act 74, Mich. P.A. 1970

For corners in

<u>Huron</u> (County)	Located In:	Corner Code #
1. Public Land Survey	Huron T <u>18</u> N R <u>14</u> E	<u>A-13</u>
	T___R___	_____
	T___R___	_____
	T___R___	_____
2. Property Controlling in Section	S___T___R___	_____
	S___T___R___	_____
3. Miscellaneous Property in Sec.	S___T___R___	_____
	S___T___R___	_____

STATE OF MICHIGAN  
 HURON COUNTY  
 RECORDED

28 OCT 99 9:13 A.M.

FRANCES L. HOLDWICK  
 REGISTER OF DEEDS

Register of Deeds Stamp & File Number

4. Lot No. \_\_\_\_\_, Recorded Plat \_\_\_\_\_  
 5. Private Claims \_\_\_\_\_

I, Charles S. Getz, in a field survey on April 12, 1999 do hereby state that under requirements of P.A. 74, Michigan P.A. of 1970, the corner points mentioned in lines 1 and 2 above were in conformance with regulations and rules therefore as required in the current manual of survey instructions of the United States Department of the Interior, Bureau of Land Management or by a decree of a Court of Law and/or that the corner points mentioned in lines 3, 4 and 5 above were in conformance with the rules of the Michigan Board of Land Surveyors or by a Decree of a Court of Law; established, re-established, monumented, recovered, found as expressed below:

NOTE: Not more than 2 corners, all in the same town and range, may be recorded on this certificate.

	A	B	C	D	E	F	G	H	I	J	K	L	M
1													
2	6	5	4	3	2	1							
3													
4	7	8	9	10	11	12							
5													
6	18	17	16	15	14	13							
7													
8	19	20	21	22	23	24							
9													
10	30	29	28	27	26	25							
11													
12	31	32	33	34	35	36							
13													

A. Description of original monument and accessories and/or subsequent restoration:

A-13 1834 G.L.O., H. Parke D.S. County Road Commission Records - Monument  
 Post Recorded Surveys -  
 Hemlock 26", N10°E, 8 Links Case, 5-9-72, Liber 1, Page 194, Mon. box  
 Fir 11", S16½°E, 32 Links Case, 8-23-78, Liber 3, Page 490, steel pin in Mon. box  
 Case, 8-23-78, Liber 3, Page 593, Mon. box in place.  
 L.C.R.C. - NONE Case, 5-12-80, Liber 4, Page 289, Pin in Mon. Box in place.  
 Unrecorded Surveys - NONE  
 County Surveyor Records -  
 November 19th, 1901  
 May 11th, 1911  
 Surveys show Corner

B. Description of corner evidence found and/or method applied in restoring or reestablishing corner:

A-13  
 SW Cor, Section 31, T18N-R14E  
 Found Monument Box  
 Accepted as the best available evidence  
 of original corner position  
 (Intersection of Kinde and Verona Roads)


REMONUMENTATION

FEB 13 2000

SECTION

C. Description of monument for corner and accessories established to perpetuate locating the position of the corner:

A-13  
 SW Cor, Section 31, T18N-R14E  
 Set 1/2" Iron Bar in Monument Box (Capped)  
 N45°E 61.60' to Nail in Telephone Pole  
 N45°W 58.30' to Nail in Power Pole  
 S45°E 61.40' to Nail in Telephone Pole  
 S30°W 78.80' to Northeast Corner of Building  
 S50°W 80.15' to Northwest Corner of Building  
 West 2630.18' to S 1/4 Cor, Sec 36, T18N-R13E  
 East 2500.47' to S 1/4 Cor, Sec 31, T18N-R14E

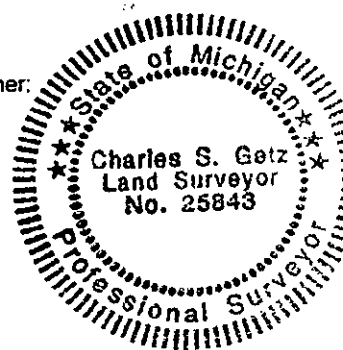

Signed by Charles S. Getz

Date August 14, 1999

Surveyor's Michigan License No. 25843

PEER GROUP APPROVED AT MEETING  
 HELD October 26, 1999. *R.S.B.*