

Re Mon Liber 1, Page 248

1999 REMONUMENTATION

LAND CORNER RECORDATION CERTIFICATE  
Filing Requirement of Act 74, Mich. P.A. 1970

STATE OF MICHIGAN  
HURON COUNTY  
RECORDED

28 OCT 99 9:13 A.M.

FRANCES L. HOLDWICK  
REGISTER OF DEEDS

For corners in

	Huron	Located in:	Corner Code #
	(County)		
1. Public Land Survey	Huron	T18N R14E	B-13
		T R	
		T R	
		T R	
2. Property Controlling in Section	S	T R	
	S	T R	
3. Miscellaneous Property in Sec.	S	T R	
	S	T R	

Register of Deeds Stamp & File Number

4. Lot No. \_\_\_\_\_, Recorded Plat \_\_\_\_\_  
5. Private Claims \_\_\_\_\_

I, Charles S. Getz, in a field survey on April 14, 1999 do hereby state that under requirements of P.A. 74, Michigan P.A. of 1970, the corner points mentioned in lines 1 and 2 above were in conformance with regulations and rules therefore as required in the current manual of survey instructions of the United States Department of the Interior, Bureau of Land Management or by a decree of a Court of Law and/or that the corner points mentioned in lines 3, 4 and 5 above were in conformance with the rules of the Michigan Board of Land Surveyors or by a Decree of a Court of Law, established, re-established, monumented, recovered, found as expressed below:

	A	B	C	D	E	F	G	H	I	J	K	L	M
1													
2	6	5	4										
3													
4	7	8	9	10	11	12							
5													
6	10	17	16	15	14	13							
7													
8	19	20	21	22	23	24							
9													
10	30	29	28	27	26	25							
11													
12	31	32	33	34	35	36							
13													


NOTE: Not more than 2 corners, all in the same town and range, may be recorded on this certificate.

A. Description of original monument and accessories and/or subsequent restoration:  
 B-13 1834 G.L.O., H. Parke D.S. County Road Commission Records - Refer to Bloomfield Corner (T17N-R14E)  
 Set quarter section post Recorded Surveys - NONE  
 Hemlock 10", N51°E, 40 Links  
 B. Ash 6", N54½°W, 8 Links Unrecorded Surveys - NONE  
 L.C.R.C. - NONE  
 County Surveyor Records - NONE

REMONUMENTATION  
FEB 03 2000  
SECTION

B. Description of corner evidence found and/or method applied in restoring or reestablishing corner:  
 B-13  
 S 1/4 Cor, Section 31, T18N-R14E  
 Found no evidence of original corner position  
 Re-established corner position by proportionate measure from G.L.O. Notes,  
 between C-13 and A-13 as best evidence of original corner position for B-13.  
 (On Kinde Road)

C. Description of monument for corner and accessories established to perpetuate locating the position of the corner:  
 B-13  
 S 1/4 Cor, Section 31, T18N-R14E  
 Set 1/2" Re-Rod in Monument Box (Capped)  
 East 86.98' to Monument Box  
 North 49.60' to Metal Anchor Pole  
 N30°E 44.62' to Nail in Power Pole  
 West 2500.47' to SW Cor, Sec 31, T18N-R14E  
 East 2632.07' to SE Cor, Sec 31, T18N-R14E

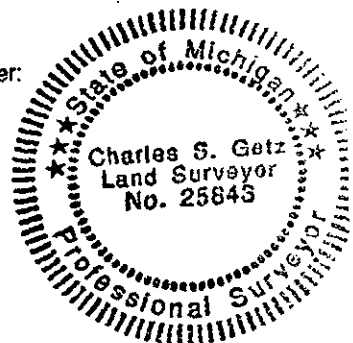

Signed by Charles S. Getz  
Surveyor's Michigan License No. 25843

Date August 16, 1999

PEER GROUP APPROVED AT MEETING  
HELD October 26, 1999 R.A.B.