

Re Mon Libew!, Page 250

1999 REMONUMENTATION

LAND CORNER RECORDATION CERTIFICATE
Filing Requirement of Act 74, Mich. P.A. 1970

STATE OF MICHIGAN
HURON COUNTY
RECORDED

28 OCT 99 9:13 A.M.

FRANCES L. HOLDWICK
REGISTER OF DEEDS

For corners in

Huron (County)	Located In:	Corner Code #
1. Public Land Survey	Huron T18N R14E	D-13
	T R	
	T R	
	T R	
2. Property Controlling in Section	S T R	
	S T R	
3. Miscellaneous Property in Sec.	S T R	
	S T R	

Register of Deeds Stamp & File Number

- 4. Lot No. _____, Recorded Plat _____
- 5. Private Claims _____

I, Charles S. Getz, in a field survey on April 14, 1999 do hereby state that under requirements of P.A. 74, Michigan P.A. of 1970, the corner points mentioned in lines 1 and 2 above were in conformance with regulations and rules therefore as required in the current manual of survey instructions of the United States Department of the Interior, Bureau of Land Management or by a decree of a Court of Law and/or that the corner points mentioned in lines 3, 4 and 5 above were in conformance with the rules of the Michigan Board of Land Surveyors or by a Decree of a Court of Law; established, re-established, monumented, recovered, found as expressed below:

NOTE: Not more than 2 corners, all in the same town and range, may be recorded on this certificate.

	A	B	C	D	E	F	G	H	I	J	K	L	M
1													
2	6		5		4			3		2			1
3													
4	7		8		9			10		11			12
5													
6	18		17		16			15		14			13
7													
8	19		20		21			22		23			24
9													
10	30		29		28			27		26			25
11													
12	31		32		33			34		35			36
13													

A. Description of original monument and accessories and/or subsequent restoration:
 D-13 1834 G.L.O., H. Parke D.S. County Road Commission Records - Refer to Bloomfield Corner (T17N-R14E)
 Set quarter section post Recorded Surveys - NONE
 Hemlock 18", N30 1/2°E, 30 Links
 Birch 9", N72°W, 35 Links Unrecorded Surveys - NONE
 L.C.R.C. - NONE
 County Surveyor Records -
 April 13th, 1910
 Survey shows Corner

REMONUMENTATION

FEB 13 2001


SECTION

B. Description of corner evidence found and/or method applied in restoring or reestablishing corner:

D-13
 S 1/4 Cor, Section 32, T18N-R14E
 Found no evidence of original corner position
 Re-established corner position by proportionate measure from G.L.O. Notes,
 between E-13 and C-13 as best evidence of original corner position for D-13
 (On Kinde Road)

C. Description of monument for corner and accessories established to perpetuate locating the position of the corner:

D-13
 S 1/4 Cor, Section 32, T18N-R14E
 Set 1/2" Iron Bar in Monument Box (Capped)
 East 105.62' to Monument Box
 S25°E 83.40' to Nail in Thorn Apple Tree
 N40°W 80.60' to Nail in Power Pole
 N75°E 111.40' to Nail in Fence Post
 West 2655.75' to SW Cor, Sec 32, T18N-R14E
 East 2655.75' to SE Cor, Sec 32, T18N-R14E

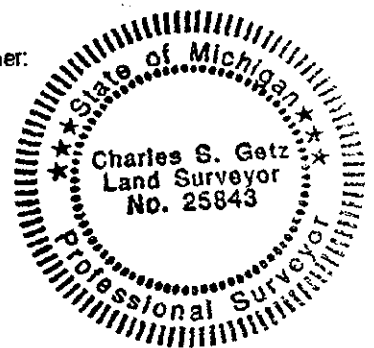

Signed by Charles S. Getz
 Surveyor's Michigan License No. 25843

Date August 16, 1999

PEER GROUP APPROVED AT MEETING R.L.B.
 HELD October 26, 1999.