

Re Mon Liber 1, Page 252

1999 REMONUMENTATION

LAND CORNER RECORDATION CERTIFICATE
Filing Requirement of Act 74, Mich. P.A. 1970

For corners in

<u>Huron</u> (County)	Located In:	Corner Code #
1. Public Land Survey	Huron T18N R14E	F-13
	T R	
	T R	
	T R	
2. Property Controlling in Section	S T R	
	S T R	
3. Miscellaneous Property in Sec.	S T R	
	S T R	

STATE OF MICHIGAN
HURON COUNTY
RECORDED

28 OCT 99 9:14 A.M.

FRANCES L. HOLLOWICK
REGISTER OF DEEDS

Register of Deeds Stamp & File Number

4. Lot No. _____, Recorded Plat _____
5. Private Claims _____

I, Charles S. Getz, in a field survey on April 14, 1999 do hereby state that under requirements of P.A. 74, Michigan P.A. of 1970, the corner points mentioned in lines 1 and 2 above were in conformance with regulations and rules therefore as required in the current manual of survey instructions of the United States Department of the Interior, Bureau of Land Management or by a decree of a Court of Law and/or that the corner points mentioned in lines 3, 4 and 5 above were in conformance with the rules of the Michigan Board of Land Surveyors or by a Decree of a Court of Law; established, re-established, monumented, recovered, found as expressed below:

A	B	C	D	E	F	G	H	I	J	K	L	M
1												
2	6		5		4		3		2		1	
3												
4	7		8		9		10		11		12	
5												
6	18		17		16		15		14		13	
7												
8	19		20		21		22		23		24	
9												
10	30		29		28		27		26		25	
11												
12	31		32		33		34		35		36	
13												

NOTE: Not more than 2 corners, all in the same town and range, may be recorded on this certificate.

A. Description of original monument and accessories and/or subsequent restoration:

F-13 1834 G.L.O., H. Parke D.S.	County Road Commission Records - Iron Pin in Post
Set quarter section post	Recorded Surveys -
Beech 6", N87°E, 7 Links	Brown, 3-24-80, Liber 4, Page 255, P.K. Nail over Iron Pin
Hemlock 12", N30°W, 41 Links	Unrecorded Surveys -
L.C.R.C. - NONE	Case, 1-4-63, Iron in Place
	Case, 8-30-83, P.K. Nail over steel stake
County Surveyor Records - NONE	Brown, 1-30-97, 3/4" Steel Stake in Mon Box
	Brown, 11-19-97, 3/4" Steel Stake in Mon. Box

B. Description of corner evidence found and/or method applied in restoring or reestablishing corner:

F-13
S 1/4 Cor, Section 33, T18N-R14E
Found 3/4" Steel Stake in Monument Box
Accepted as the best available evidence of original corner position
(Intersection of Kinde & Huron City Roads)


PREPARED BY

SECTION

SECTION

C. Description of monument for corner and accessories established to perpetuate locating the position of the corner:

F-13
S 1/4 Cor, Section 33, T18N-R14E
Found 3/4" Steel Stake in Monument Box
East 126.40' to Monument Box
N30°E 66.25' to Nail in Power Pole
S20°W 56.30' to Nail in Power Pole
S45°E 69.68' to Northwest Corner of Store Building
N10°W 54.80' to Northeast Corner of Building
N15°W 55.20' to Southwest Corner of Building
West 2640.94' to SW Cor, Sec 33, T18N-R14E
East 2643.16' to SE Cor, Sec 33, T18N-R14E

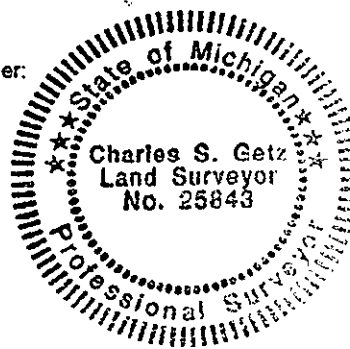

Signed by Charles S. Getz

Date August 16, 1999

Surveyor's Michigan License No. 25843

PEER GROUP APPROVED AT MEETING
HELD October 26, 1999 R.L.B.