

Re Mon River, Page 254

1999 REMONUMENTATION

LAND CORNER RECORDATION CERTIFICATE  
Filing Requirement of Act 74, Mich. P.A. 1970

For corners in

<u>Huron</u> (County)	Located In:	Corner Code #
1. Public Land Survey	Huron T18N R14E	H-13
	T R	
	T R	
	T R	
2. Property Controlling in Section	S T R	
	S T R	
3. Miscellaneous Property in Sec.	S T R	
	S T R	

STATE OF MICHIGAN  
HURON COUNTY  
RECORDED  
28 OCT 99 9:14 A.M.  
FRANCES L. HOLDWICK  
REGISTER OF DEEDS

Register of Deeds Stamp & File Number

4. Lot No. \_\_\_\_\_, Recorded Plat \_\_\_\_\_  
5. Private Claims \_\_\_\_\_

I, Charles S. Getz, in a field survey on April 14, 1999 do hereby state that under requirements of P.A. 74, Michigan P.A. of 1970, the corner points mentioned in lines 1 and 2 above were in conformance with regulations and rules therefore as required in the current manual of survey instructions of the United States Department of the Interior, Bureau of Land Management or by a decree of a Court of Law and/or that the corner points mentioned in lines 3, 4 and 5 above were in conformance with the rules of the Michigan Board of Land Surveyors or by a Decree of a Court of Law; established, re-established, monumented, recovered, found as expressed below:

	A	B	C	D	E	F	G	H	I	J	K	L	M
1													
2		6		5		4		3		2		1	
3													
4		7		8		9		10		11		12	
5													
6		18		17		16		15		14		13	
7													
8		19		20		21		22		23		24	
9													
10		30		29		28		27		26		25	
11													
12		31		32		33		34		35		36	
13													

NOTE: Not more than 2 corners, all in the same town and range, may be recorded on this certificate.


A. Description of original monument and accessories and/or subsequent restoration:  
H-13 1834 G.L.O., H. Parke D.S. County Road Commission Records - Steel Pin  
Set quarter section post Recorded Surveys - NONE  
Hemlock 16", N66°E, 16 Links Unrecorded Surveys - NONE  
Beech 7", N14½°W, 31 Links  
L.C.R.C. - NONE

County Surveyor Records -  
March 21-1895  
Survey shows Corner

B. Description of corner evidence found and/or method applied in restoring or reestablishing corner:  
H-13  
S 1/4 Cor, Section 34, T18N-R14E  
Found 3/4" Iron Bar in Monument Box  
Accepted as the best available evidence of original corner position  
(Intersection of Kinde & Tinsey Roads)

RECORDED  
FEB 28 1999  
SECTION

C. Description of monument for corner and accessories established to perpetuate locating the position of the corner:  
H-13  
S 1/4 Cor, Section 34, T18N-R14E  
Found 3/4" Iron Bar in Monument Box  
East 54.08' to Monument Box  
South 20.70' to East Leg of Road Sign  
S45°E 67.70' to Northwest Corner of Stone Pillar  
N30°E 73.35' to Nail in Power Pole  
N25°E 56.70' to Nail in Telephone Pole  
West 2652.54' to SW Cor, Sec 34, T18N-R14E  
East 2653.32' to SE Cor, Sec 34, T18N-R14E

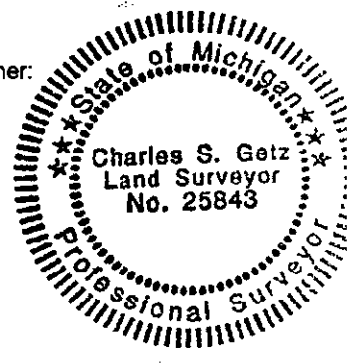

Signed by Charles S. Getz  
Surveyor's Michigan License No. 25843

Date August 16, 1999

PEER GROUP APPROVED AT MEETING  
HELD October 26, 1999 R.S.B.