

Re Mon Liberl, Page 256

1999 REMONUMENTATION

LAND CORNER RECORDATION CERTIFICATE  
Filing Requirement of Act 74, Mich. P.A. 1970

For corners in

Huron (County)	Located In:	Corner Code #
1. Public Land Survey	Huron T18N R14E	J-13
	T R	
	T R	
	T R	
2. Property Controlling in Section	S T R	
	S T R	
3. Miscellaneous Property in Sec.	S T R	
	S T R	

STATE OF MICHIGAN  
HURON COUNTY  
RECORDED

28 OCT 99 9:15 A.M.

FRANCES L. HOLLOWAY  
REGISTER OF DEEDS

Register of Deeds Stamp & File Number

4. Lot No. \_\_\_\_\_, Recorded Plat \_\_\_\_\_  
5. Private Claims \_\_\_\_\_

I, Charles S. Getz, in a field survey on April 14, 1999 do hereby state that under requirements of P.A. 74, Michigan P.A. of 1970, the corner points mentioned in lines 1 and 2 above were in conformance with regulations and rules therefore as required in the current manual of survey instructions of the United States Department of the Interior, Bureau of Land Management or by a decree of a Court of Law and/or that the corner points mentioned in lines 3, 4 and 5 above were in conformance with the rules of the Michigan Board of Land Surveyors or by a Decree of a Court of Law; established, re-established, monumented, recovered, found as expressed below:

NOTE: Not more than 2 corners, all in the same town and range, may be recorded on this certificate.

	A	B	C	D	E	F	G	H	I	J	K	L	M
1													
2	6	5	4	3	2	1							
3													
4	7	8	9	10	11	12							
5													
6	18	17	16	15	14	13							
7													
8	19	20	21	22	23	24							
9													
10	30	29	28	27	26	25							
11													
12	31	32	33	34	35	36							
13													

A. Description of original monument and accessories and/or subsequent restoration:

J-13 1834 G.L.O., H. Parke D.S. County Road Commission Records - Appears to refer to Bloomfield Cor  
 Set quarter section post Recorded Surveys - NONE  
 Pine 24", N38 1/2°E, 9 1/2 Links  
 B. Ash 16", N50°W, 14 Links Unrecorded Surveys - NONE  
 L.C.R.C. - NONE


County Surveyor Records -  
March 18 - 1895 - Survey shows Corner

B. Description of corner evidence found and/or method applied in restoring or reestablishing corner:

J-13  
 S 1/4 Cor, Section 35, T18N-R14E  
 Found no evidence of original corner position  
 Re-established corner position by proportionate measure from G.L.O. Notes, between K-13 and I-13 as best evidence of original corner position for J-13 (On Kinde Road)

C. Description of monument for corner and accessories established to perpetuate locating the position of the corner:

J-13  
 S 1/4 Cor, Section 35, T18N-R14E  
 Set 1/2" Iron Bar in Monument Box (Capped)  
 East 35.55' to Monument Box  
 S30°E 50.10' to Nail in Fence Post  
 N30°W 51.80' to Culvert  
 N70°E 123.50' to Nail in Power Pole  
 West 2645.21' to SW Cor, Sec 35, T18N-R14E  
 East 2645.21' to SE Cor, Sec 35, T18N-R14E

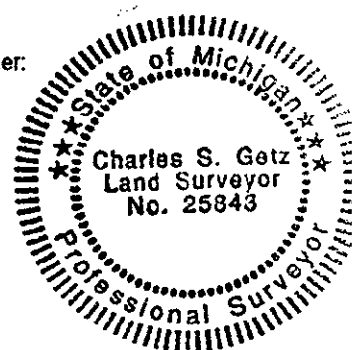

Signed by Charles S. Getz  
 Surveyor's Michigan License No. 25843

Date August 21, 1999

PEER GROUP APPROVED AT MEETING R.L.B.  
HELD October 26, 1999