

Re Monolith 1, Page 257

1999 REMONUMENTATION

LAND CORNER RECORDATION CERTIFICATE
Filing Requirement of Act 74, Mich. P.A. 1970

For corners in

Huron

(County)

Located in:

Corner Code #

1. Public Land Survey	Huron	T18N R14E	K-13
		T R	
		T R	
		T R	
2. Property Controlling in Section	S	T R	
	S	T R	
3. Miscellaneous Property in Sec.	S	T R	
	S	T R	

STATE OF MICHIGAN
HURON COUNTY
RECORDED

28 OCT 99 9:15 A.M.

FRANCES L. HOLDWICK
REGISTER OF DEEDS

Register of Deeds Stamp & File Number

4. Lot No. _____, Recorded Plat _____
5. Private Claims _____

I, Charles S. Getz, in a field survey on April 14, 1999 do hereby state that under requirements of P.A. 74, Michigan P.A. of 1970, the corner points mentioned in lines 1 and 2 above were in conformance with regulations and rules therefore as required in the current manual of survey instructions of the United States Department of the Interior, Bureau of Land Management or by a decree of a Court of Law and/or that the corner points mentioned in lines 3, 4 and 5 above were in conformance with the rules of the Michigan Board of Land Surveyors or by a Decree of a Court of Law, established, re-established, monumented, recovered, found as expressed below:

NOTE: Not more than 2 corners, all in the same town and range, may be recorded on this certificate.

1	A	B	C	D	E	F	G	H	I	J	K	L	M
2		6		5		4		3		2		1	
3													
4		7		8		9		10		11		12	
5													
6		18		17		16		15		14		13	
7													
8		19		20		21		22		23		24	
9													
10		30		29		28		27		26		25	
11													
12		31		32		33		34		35		36	
13													

A. Description of original monument and accessories and/or subsequent restoration:

K-13 1834 G.L.O., H. Parke D.S.

County Road Commission Records - NONE

Set Post

Hanlock 12", N89°W, 12 Links

Do. 10", N78°E, 9 Links

Recorded Surveys - NONE

L.C.R.C. - NONE

Unrecorded Surveys -

Brown, 10-30-91, P.K. Nail

County Surveyor Records -

March 18 - 1895

Surveys

April 18th, 1884

show Corner

B. Description of corner evidence found and/or method applied in restoring or reestablishing corner:

K-13

SW Cor, Section 36, T18N-R14E

Found P.K. Nail as per Survey by Huron Surveying, Inc. dated 10-30-91

Accepted as the best available evidence

of original corner position

(Intersection of Kinde & Minden Roads)

C. Description of monument for corner and accessories established to perpetuate locating the position of the corner:

K-13

SW Cor, Section 36, T18N-R14E

Set 1/2" Iron Bar in Monument Box (Capped)

East 40.92' to Monument Box

N20°W 72.80' to Nail in Power Pole


N30°W 54.30' to Nail in Fence Post

South 21.70' to East Leg of Road Sign

N50°E 44.55' to West Leg of Road Sign

West 2645.21' to S 1/4 Cor, Sec 35, T18N-R14E

East 2641.27' to S 1/4 Cor, Sec 36, T18N-R14E

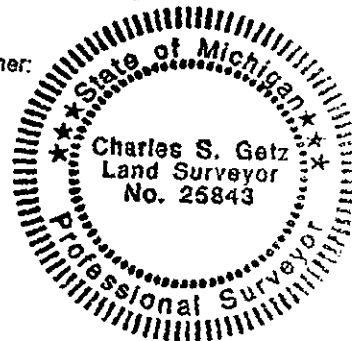

Signed by Charles S. Getz

Surveyor's Michigan License No. 25843

Date August 21, 1999

PEER GROUP APPROVED AT MEETING
HELD October 26, 1999 R.A.B.