

Common to:
 A01 - Rubicon Twp. - T17N-R15E
 M01 - Bloomfield Twp. - T17N-R14E
 M13 - Huron Twp. - T18N-R14E

Re-man Liber 1, Page 260

1999 REMONUMENTATION

LAND CORNER RECORDATION CERTIFICATE
 Filing Requirement of Act 74, Mich. P.A. 1970

For corners in

Huron

(County)

Located In:

Corner Code #

1. Public Land Survey

Gore

T18N R15E

A-13

T R

T R

T R

2. Property Controlling in Section

S

T R

3. Miscellaneous Property in Sec.

S

T R

S

T R

4. Lot No. _____, Recorded Plat _____
 5. Private Claims _____

STATE OF MICHIGAN
 HURON COUNTY
 RECORDED

28 OCT 99 9:17 A.M.

FRANCES L. HOLWICK
 REGISTER OF DEEDS

Register of Deeds Stamp & File Number

	A	B	C	D	E	F	G	H	I	J	K	L	M
1													
2	6	5	4	3	2	1							
3													
4	7	8	9	10	11	12							
5													
6	18	17	16	15	14	13							
7													
8	19	20	21	22	23	24							
9													
10	30	29	28	27	26	25							
11													
12	31	32	33	34	35	36							
13													

I, Charles S. Getz, in a field survey on April 14, 1999 do hereby state that under requirements of P.A. 74, Michigan P.A. of 1970, the corner points mentioned in lines 1 and 2 above were in conformance with regulations and rules therefore as required in the current manual of survey instructions of the United States Department of the Interior, Bureau of Land Management or by a decree of a Court of Law and/or that the corner points mentioned in lines 3, 4 and 5 above were in conformance with the rules of the Michigan Board of Land Surveyors or by a Decree of a Court of Law, established, re-established, monumented, recovered, found as expressed below.

NOTE: Not more than 2 corners, all in the same town and range, may be recorded on this certificate.

A. Description of original monument and accessories and/or subsequent restoration:

A-13 1834 G.L.O., H. Parke D.S.

Post

Hemlock 14", N85°E, 9 Links
 Beech 11", N76°W, 24 Links

County Road Commission Records - Iron Pin in Post

Recorded Surveys -

Case, 1-20-72, Liber 1, Page 130, Iron Pin

Case, 8-3-73, Liber 1, Page 523, P.K. nail over steel pin

Unrecorded Surveys -

Brown, 5-17-93, 3/4" Re-Rod in Mon. Box

Brown, 8-10-94, 3/4" Steel Stake in Monument Box

L.C.R.C. - NONE

County Surveyor Records -

April 18th, 1884

January 7, 1893

Surveys show Corner

B. Description of corner evidence found and/or method applied in restoring or reestablishing corner:

A-13

SW Cor, Section 31, T18N-R15E

Found 3/4" Iron Bar in Monument Box

Accepted as the best available evidence

of original corner position

(Intersection of Kinde & Finkel Roads)

C. Description of monument for corner and accessories established to perpetuate locating the position of the corner:

A-13

SW Cor, Section 31, T18N-R15E

Found 3/4" Iron Bar in Monument Box

N30°W 71.95' to Nail in Power Pole

N35°W 59.25' to Nail in Telephone Pole

S20°W 58.32' to Nail in Ash Tree

S20°E 43.20' to Stop Sign


West 2641.27' to S 1/4 Cor, Sec 36, T18N-R14E

East 2645.87' to S 1/4 Cor, Sec 31, T18N-R15E

RECORDED

FEB 2 1999

SECTION

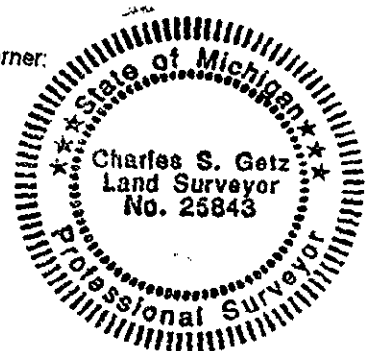

Signed by Charles S. Getz

Surveyor's Michigan License No. 25843

Date August 21, 1999

PEER GROUP APPROVED AT MEETING
 HELD October 26, 1999 R.S.D.