

Re Mon Liber 1, Page 262

1999 REMONUMENTATION

LAND CORNER RECORDATION CERTIFICATE
Filing Requirement of Act 74, Mich. P.A. 1970

STATE OF MICHIGAN
HURON COUNTY
RECORDED

28 OCT 99 9:17 A.M.

FRANCES L. HOLDWICK
REGISTER OF DEEDS

For corners in

<u>Huron</u> (County)	Located In:	Corner Code #
1. Public Land Survey	Gore T18N R15E	C-13
	T R	
	T R	
	T R	
2. Property Controlling in Section	S T R	
	S T R	
3. Miscellaneous Property in Sec.	S T R	
	S T R	

Register of Deeds Stamp & File Number

4. Lot No. _____, Recorded Plat _____
5. Private Claims _____

I, Charles S. Getz, in a field survey on April 14, 1999 do hereby state that under requirements of P.A. 74, Michigan P.A. of 1970, the corner points mentioned in lines 1 and 2 above were in conformance with regulations and rules therefore as required in the current manual of survey instructions of the United States Department of the Interior, Bureau of Land Management or by a decree of a Court of Law and/or that the corner points mentioned in lines 3, 4 and 5 above were in conformance with the rules of the Michigan Board of Land Surveyors or by a Decree of a Court of Law; established, re-established, monumented, recovered, found as expressed below:

NOTE: Not more than 2 corners, all in the same town and range, may be recorded on this certificate.

	A	B	C	D	E	F	G	H	I	J	K	L	M
1													
2		6		5		4		3		2		1	
3													
4		7		8		9		10		11		12	
5													
6		18		17		16		15		14		13	
7													
8		19		20		21		22		23		24	
9													
10		30		29		28		27		26		25	
11													
12		31		32		33		34		35		36	
13													

A. Description of original monument and accessories and/or subsequent restoration:

C-13 1834 G.L.O., H. Parke D.S. County Road Commission Records - 3/4" Iron Pin
 Set Post Recorded Surveys -
 Cedar 8", N80°W, 10 1/2 Links Case, 3-2-73, Liber 1, Page 415, 3/4" iron pin
 do. 8", N47°E, 91 Links Brown, 5-15-97, Liber 5, Page 186, 3/4" Iron Pin in Mon. Box
 L.C.R.C. - NONE Unrecorded Surveys -
 Case, 8-27-93, 3/4" steel pin in Mon. Box
 County Surveyor Records - NONE


B. Description of corner evidence found and/or method applied in restoring or reestablishing corner:

C-13
 SW Cor, Section 32, T18N-R15E
 Found 3/4" Iron Bar in Monument Box
 Accepted as the best available evidence of original corner position
 (Intersection of Pochert & Kinde Roads)

RECORDED
 FEB 11 1999
 SECTION

C. Description of monument for corner and accessories established to perpetuate locating the position of the corner:

C-13
 SW Cor, Section 32, T18N-R15E
 Found 3/4" Iron Bar in Monument Box
 West 52.14' to P.K. Nail
 South 21.00' to East Leg of Road Sign
 N30°W 69.85' to Nail in Power Pole
 N25°E 69.70' to Nail in Power Pole
 S50°W 44.44' to Stop Sign
 West 2650.30' to S 1/4 Cor, Sec 31, T18N-R15E
 East 2646.79' to S 1/4 Cor, Sec 32, T18N-R15E

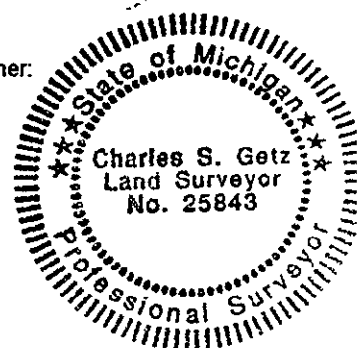

Signed by Charles S. Getz
 Surveyor's Michigan License No. 25843

Date August 21, 1999

PEER GROUP APPROVED AT MEETING
 HELD October 26, 1999. *R.P.B.*