

Re-Mon. Liber 2, Page 26

1999 REMONUMENTATION  
LAND CORNER RECORDATION CERTIFICATE  
Filing Requirement of Act 74, Mich. P.A. 1970

For Corners in Gore Township

<u>Huron</u> (County)	Located in:	Corner Code #
1. Public Land Survey	T 18N R 15E	F - 13
	T ----- R -----	
	T ----- R -----	
	T ----- R -----	
2. Property Controlling S in Section S	T ----- R -----	
	T ----- R -----	
3. Miscellaneous S Property in Sec. S	T ----- R -----	
	T ----- R -----	

STATE OF MICHIGAN  
HURON COUNTY  
RECORDED


30 DEC 99 2:13 P.M.

FRANCES L. HOLDWICK  
REGISTER OF DEEDS

Register of Deeds Stamp & File Number

4. Lot No. \_\_\_\_\_, Recorded Plat \_\_\_\_\_  
5. Private Claims \_\_\_\_\_

SECTION

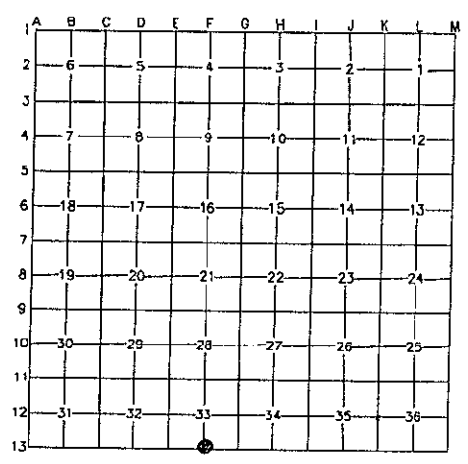

I, Russell L. Brown, in a field survey on July 1, 1999 do hereby state that under requirements of P.A. 74, Michigan P.A. of 1970, the corner points mentioned in lines 1 and 2 above were in conformance with regulations and rules therefore as required in the current manual of survey instructions of the United States Department of the Interior, Bureau of Land Management or by a decree of a Court of Law and/or that the corner points mentioned in lines 3, 4, and 5 above were in conformance with the rules of the Michigan Board of Land Surveyors or by a Decree of a Court of Law; established, re-established, monumented, recovered, found as expressed below:

NOTE: Not more than 2 corners, all in the same town and range, may be recorded on this certificate.

A. Description of original monument and accessories and/or subsequent restoration:  
 1834 GLO, H. Parke D.S. Set quarter Section Post, Beech 9 N69E 19, Hemlock 7 N32 1/2W 33 1/2  
 County Surveyors Records - None  
 County Road Commission Records - None  
 L.C.R.C. - None  
 Recorded Surveys: Sept. 18, 1953, liber 4 Plats Page 56, Bass Bay Subdivision, Galen W. Case #7431 no object stated, no witnesses given  
 Unrecorded Surveys: Nov. 10, 1988, Huron Surveying, Inc. Russell L. Brown P.S. 24588, Found 1 1/2" Pipe East 79.8' spike in S. Side of 5" Poplar, S70°E 70.82' to 1/2" Dia. Steel Stake, South 6.9' Spike in East Side of 4" Ash

B. Description of corner evidence found and/or method applied in restoring or reestablishing corner:


No evidence of original Corner or Accessories Found.  
 Found 1 1/2" Dia. Pipe  
 Accepted Found 1 1/2" Pipe as best evidence of original Corner Position

C. Description of monument for corner and accessories established to perpetuate locating the position of the corner:

F - 13, S. 1/4 Corner Section 33, T18N-R15E  
 Found 1 1/2" Dia. Pipe  
 WITNESSES  
 South 71.78' to Spike in East Side of 6" Ash Tree  
 S85°E 20.55' to Spike in North Side of 10" Apple Tree  
 N15°W 16.00' to Spike in East Side of 12" Ash Tree  
 West 36.51' to Spike in South Side of 8" Ash Tree  
 West 2622.81' to E - 13, S.W. Corner Section 33, T18N-R15E

Signed by Russell L. Brown  
 Surveyor's Michigan License No. 24588

Date Dec. 27, 1999

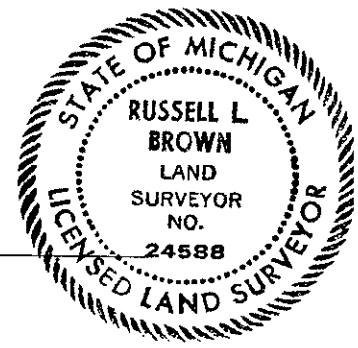

Peer group approved at meeting held 12-27-99 0, 0. RLB