

Re-Mon. Liber 2, Page 25

1999 REMONUMENTATION
LAND CORNER RECORDATION CERTIFICATE
Filing Requirement of Act 74, Mich. P.A. 1970

For Corners in GORE Township

<u>Huron</u> (County)	Located in:	Corner Code #
1. Public Land Survey	T 18N R 15E	1
	T-----R-----	
	T-----R-----	
	T-----R-----	
2. Property Controlling S in Section S	T-----R-----	
3. Miscellaneous S Property in Sec. S	T-----R-----	
	T-----R-----	

STATE OF MICHIGAN
HURON COUNTY
RECORDED
30 DEC 99 2:13 P.M.
FRANCES L. HOLDWICK
REGISTER OF DEEDS

Register of Deeds Stamp & File Number

SECTION

4. Lot No. _____, Recorded Plat _____
5. Private Claims _____

1	A	B	C	D	E	F	G	H	I	J	K	L	M
2	6		5		4		3		2		1		
3													
4	7		8		9		10		11		12		
5													
6	18		17		16		15		14		13		
7													
8	19		20		21		22		23		24		
9													
10	30		29		28		27		26		25		
11													
12	31		32		33		34		35		36		
13													

I, Russell L. Brown, in a field survey on July 1, 1999 do hereby state that under requirements of P.A. 74, Michigan P.A. of 1970, the corner points mentioned in lines 1 and 2 above were in conformance with regulations and rules therefore as required in the current manual of survey instructions of the United States Department of the Interior, Bureau of Land Management or by a decree of a Court of Law and/or that the corner points mentioned in lines 3, 4, and 5 above were in conformance with the rules of the Michigan Board of Land Surveyors or by a Decree of a Court of Law; established, re-established, monumented, recovered, found as expressed below:

NOTE: Not more than 2 corners, all in the same town and range, may be recorded on this certificate.

A. Description of original monument and accessories and/or subsequent restoration:
G.L.O. Meander Corner
1834 G.L.O. H. Parke D.S., Set Post on Border of Lake Huron, West Ash 10 N13W 11, Do. 9 S28E 24
County Surveyors Records - None
County Road Commission Records - None
L.C.R.C. - None
Recorded Surveys - None
Unrecorded Surveys - None


B. Description of corner evidence found and/or method applied in restoring or reestablishing corner:
Original G.L.O. meander Corner Position is not accessible due to waters of Lake Huron.

Set 1/2" x 18" Iron capped P.S. 24588 as witness to G.L.O. Meander Corner on top of high bank along Shore of Lake Huron, 64.85' West of original meander Corner position. Original meander Corner position being 58.90 chains (3887.40 feet) East of E-13, S.W. Corner of Section 33, T18N-R15E.

C. Description of monument for corner and accessories established to perpetuate locating the position of the corner:
Witness Corner to G.L.O. Meander Corner
Set 1/2"x18" Iron capped P.S. 24588
WITNESSES:
N45°W 58.31' to Spike in Easterly side of 12" Ash
S55°W 12.19' to Spike in Northerly side of 8" Ash
S15°E 7.23' to Spike in Easterly side of 15" Ash
S10°E 53.66' to Spike in Westerly side of 17" Triple Ash
East 64.85' to G.L.O. Meander Corner position
West 1199.74' to F-13, South 1/4 Corner Section 33, T18N-R15E

Signed by Russell L. Brown
Surveyor's Michigan License No. 24588

Date Dec 27, 1999

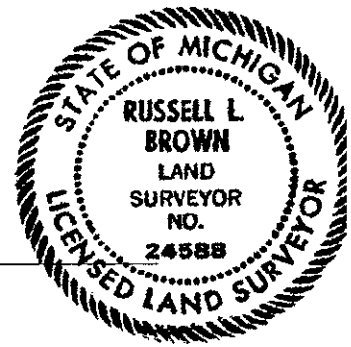

Peer group approved at meeting held 12-27-99, RLB