

Re-Mon. Liber 2, Page 39

1999 REMONUMENTATION  
LAND CORNER RECORDATION CERTIFICATE  
Filing Requirement of Act 74, Mich. P.A. 1970

For Corners in PORT AUSTIN Township

Huron (County)	Located in:	Corner Code #
1. Public Land Survey	T 19N R 13E	B - 13
	T ----- R -----	
	T ----- R -----	
	T ----- R -----	
2. Property Controlling S in Section S	T ----- R -----	
	T ----- R -----	
3. Miscellaneous S Property in Sec. S	T ----- R -----	
	T ----- R -----	

STATE OF MICHIGAN  
HURON COUNTY  
RECORDED

30 DEC 99 2:16 P.M.

FRANCES L. HOLDWICK  
REGISTER OF DEEDS

Register of Deeds Stamp & File Number

4. Lot No. \_\_\_\_\_, Recorded Plat \_\_\_\_\_

5. Private Claims \_\_\_\_\_

SECTION

A	B	C	D	E	F	G	H	I	J	K	L	M
2	6		5		4		3		2		1	
3												
4	7		8		9		10		11		12	
5												
6	18		17		16		15		14		13	
7												
8	19		20		21		22		23		24	
9												
10	30		29		28		27		26		25	
11												
12	31		32		33		34		35		36	
13												

I, Russell L. Brown, in a field survey on Dec. 10, 1999 do hereby state that under requirements of P.A. 74, Michigan P.A. of 1970, the corner points mentioned in lines 1 and 2 above were in conformance with regulations and rules therefore as required in the current manual of survey instructions of the United States Department of the Interior, Bureau of Land Management or by a decree of a Court of Law and/or that the corner points mentioned in lines 3, 4, and 5 above were in conformance with the rules of the Michigan Board of Land Surveyors or by a Decree of a Court of Law; established, re-established, monumented, recovered, found as expressed below:

NOTE: Not more than 2 corners, all in the same town and range, may be recorded on this certificate.

A. Description of original monument and accessories and/or subsequent restoration:  
 1834 G.L.O. H. Parke D.S. Set quarter Section Post, Beech 10 N28E 14 1/2, Sugar 10 N84 1/2W 36  
 County Surveyors Records - None  
 County Road Commission Records - None  
 L.C.R.C. - none  
 Recorded Surveys - None  
 Unrecorded Surveys - August 30, 1993, Huron Surveying, Inc. Russell L. Brown P.S. 24588 Found 1/2" Steel Stake  
 WITNESSES: S60°E 78.24' to Spike in Northeast side of Wood Post  
 N65°E 83.10' to Center of Cable TV Box  
 West 56.73' to 1/2" Steel Stake, North 1/4 Corner Section 6, T18N-R13E

B. Description of corner evidence found and/or method applied in restoring or reestablishing corner:  
 No evidence of original corner or accessories found.


Found 1/2" Steel Stake,

Accepted Found 1/2" Steel Stake as best evidence of original corner position.

Capped Found 1/2" Steel Stake, P.S. 24588

C. Description of monument for corner and accessories established to perpetuate locating the position of the corner:  
 B-13, South 1/4 Corner Section 31, T19N-R13E  
 Found 1/2" Steel Stake Capped 24588  
 WITNESSES:  
 N45°W 34.50' to 1/2" Steel Stake  
 S60°E 74.59' to Notch in West End 12" C.M.P.  
 S80°W 158.86' to Spike in South face Power Pole  
 N75°E 83.25' to center cable TV Box  
 West 56.73' to 1/2" Steel Stake, apparent North 1/4 Corner Section 6, T18N-R13E  
 East 2636.99' to C-13, Southeast Corner of Section 31, T19N-R13E  
 West 2739.92' to A-13, Southwest Corner of Section 31, T19N-R13E

Signed by Russell L. Brown Date Dec 27, 1999  
 Surveyor's Michigan License No. 24588

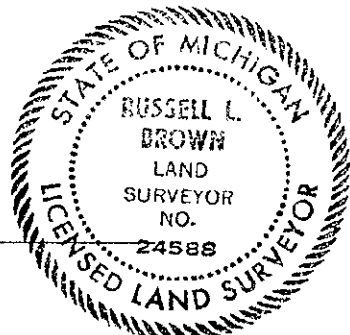

Peer group approved at meeting held 12-27-99, RLB